3940

Township No. 5 North Range No. 30 East Willamette Mer:

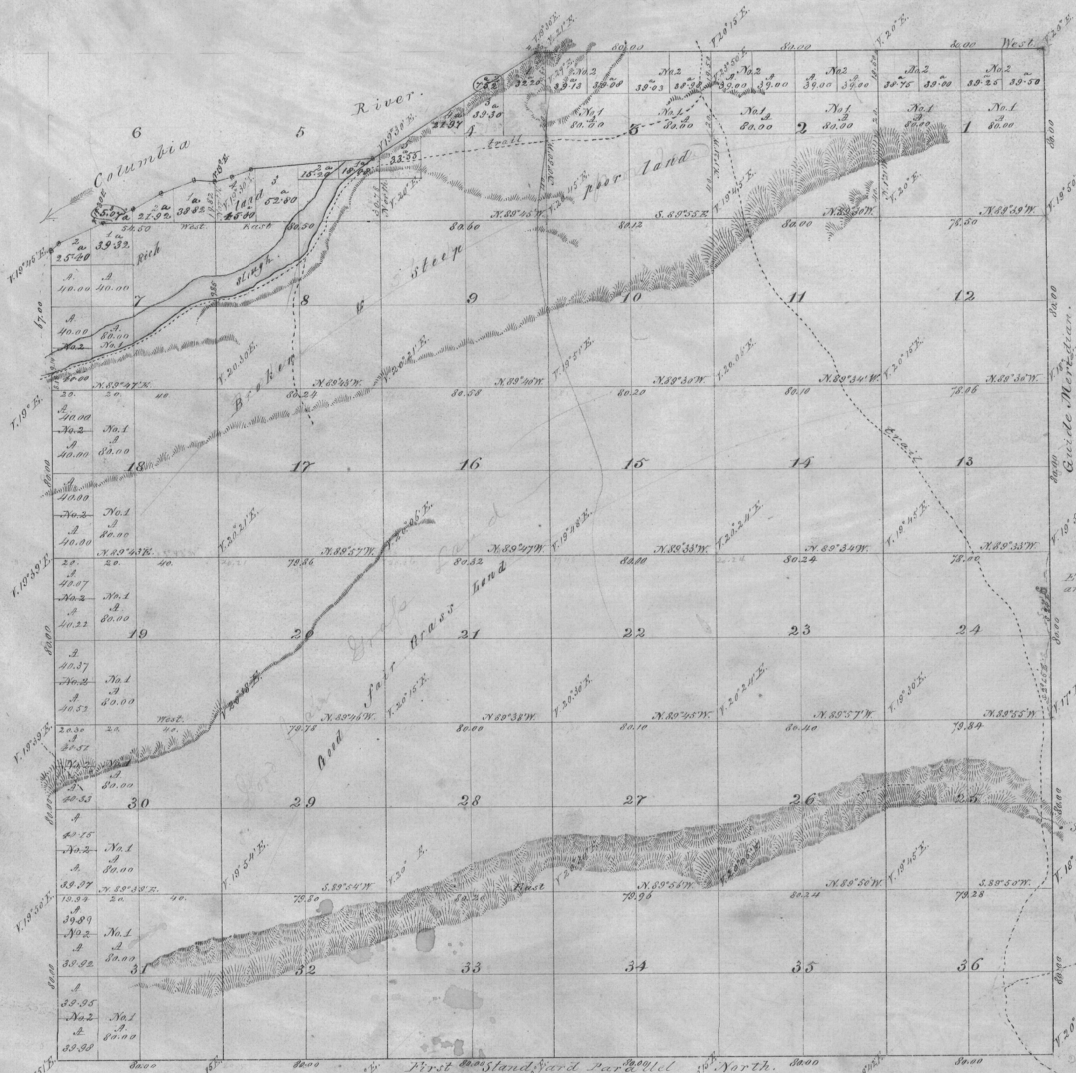

Meanders, Commencing at M.P. in North Boundary of Township.		
Course.	Chs.	lks.
S. 87° 45' W.	89	19
S. 27° 45' W.	2	86
S. 82° 30' W.	59	00
S. 70° 00' W.	10	50
S. 76° 30' W.	7	70
N. 88° 00' W.	9	00
S. 70° 00' W.	17	50
S. 41° 00' W.	15	00
S. 64° 15' W.	18	50
S. 64° 15' W.	23	32
S. 49° 00' W.	39	17
	253	17

To Sec. line bet. Secs. 4 & 5.
To head of Dry Slough.
To Sec. line bet. Secs. 5 & 6.
To Sec. line bet. Secs. 6 & 7.
To M. Ron West bound. of Tp.

East side Sec. 24 is crooked and deflects to the West. See Payne's notes

Surveys Designated.	By whom Surveyed	Contract No.	Contract Date	Amt. of Surveys: Miles	Chains	Links	When Surveyed	Date of returning notes to the Surveyor General's Office
Exterior lines North & West Boundaries	Dolphus S. Payne	100	August 1st 1861	7	71	50	Commenced Sept.	Nov. 4th 1861.
Subdivisions	" "	"	" " "	68	20	26	1861.	
Meanders	" "	"	" " "	3	18	17	Completed	
Total No. of Acres	21827.55						1861	

The above Map of Township No. 5 North Range 30 East of the Willamette Meridian, Oregon, is strictly conformable to the Field notes of the Survey thereof on file in this office, which have been examined and approved.

Surveyor Generals office
Eugene City December 7th 1861

H. H. Pengra
Surveyor General of Oregon