

PLAT AND RECORD OF SURVEY No. 219

Survey of W. Bashore Land

Course. Degree. Minutes. Chain. Links.

After duly recalling
James P. Burgess and
Wm. H. Beck
as Chainmen

Bashore as Appraiser

1/2 20' 6"

We proceeded to Survey out
W. Bashore's Land as follows
Commencing at the 1/4 sec Post
on the West boundary of Sec 35-
T6 N R 36 E

WE run East on North
boundary

East 50 00 planted Post built mound
dug pit for N. E. corner
from which we run

South 40 00 to Town line between 5 & 6 N.
of R 36 E

then we proceeded to the corner
of Secs. 2, 3, 10 & 11 T5 N R 36 E

North 60 00 we run North
Set ^{possibly a stone} post for S. W. corner

East 50 80 from which we run
planted a Stone for S. E. corner


North 23 30 then North
Town line between 5 & 6 N R 36 E
and intersect with line run South
from N. E. corner

I hereby certify that the above
is a true and correct Survey
made by me A. L. Coffey County
Surveyor Wmatilla Co Oregon

PLAT AND RECORD OF SURVEY No. 2

Plat of H. Bashore Land

Course Degrees Minutes Chains Links

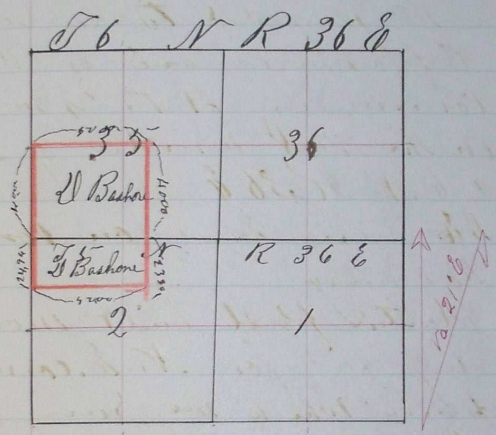


Sept 4th 1892