


Cours.	Degrees.	Minutes.	Chains.	Links.
--------	----------	----------	---------	--------

Subdivision of sections 20, 21, 27 & 32 T4S R32 E  
 for L. B. Cox and others. Survey made Sept 25<sup>th</sup>-30<sup>th</sup> 1885  
 All government corners were found as called for by notes.  
 The quarter corners at the center of sections were established  
 by right lines drawn from the opposite quarter  
 corners

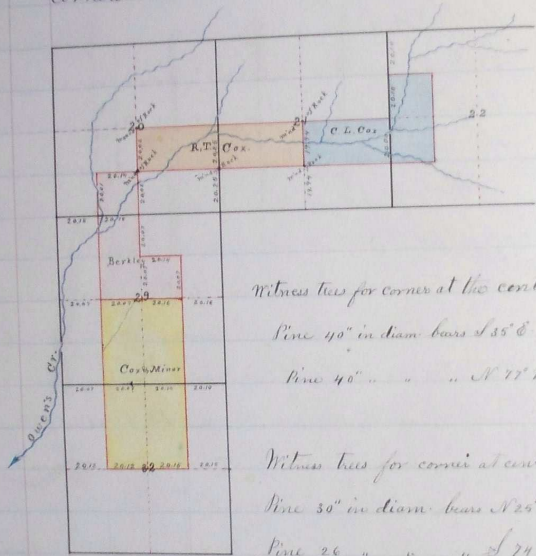

W. L. Chalk Co. Surveyor  
 by P. Zahner Sept.