


PLAT AND RECORD OF SURVEY No. 7119

Subdivision of Sec 33 T5N R35E for Geo. Carmichael and
 Y. Hutchinson Survey made 20th & 21st of October 1855.
 Sworn Chairman Burnin Niff and Elmer Brown.
 The south west corner of sec 33 being in a road was not well defined
 I therefore began at the south west cor. of sec 32 on the field this
 parallel and rease East

40 00 No signs of a

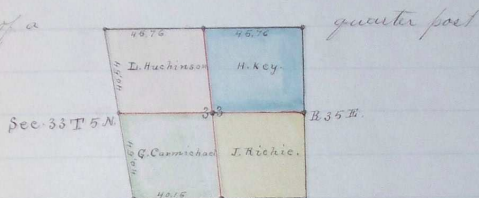

79 74 Find a rock planted and by digging down find the foot of a Birch
 wood stake in center of road underneath rock

119 37
 40 74 Quarter sec. cor. between sees 33 & 4. This quarter cor. was clearly and
 unmistakably marked. Renew this corner cor. by planting a
 rock 3" x 10" x 15" with plate ware underneath it.

Thence West and at

40 15 plant rock 4" x 8" x 17" with a Werners safe can bottle
 underneath it, at the place where I found the rock
 and foot of birch wood post.

Having erected a pole at the south west corner as established
 and one at the N.W. cor. of the section I run in a direct
 line to the N.W. corner N 7° W

40 00 Find no evidence of the original quarter section corner

51 05 Corner to sections 32, 33, 28 and 29. The mound pits and
 remnants of old cottonwood stake were found, all
 preserved. Renew corner by setting a rock 9" x 12" x 20" with pink
 bottle underneath. Thence on true line S 7° E

40 04 Set Rock 5" x 15" x 17" with brick bat underneath for quarter section
 corner between sections 32 and 33.

continued over


Begin next at the NW corner of section 33 and run East along road

40.00 Find no evidence of corner after digging up the ground in the vicinity, excepting a fence extending from the South East and one from the North East

91.52 Dig and find remnants of charred stake, also fence from the North and South are built to this point also measure East 9 chains and a fraction as called for by the government notes and find old road crossing line. The evidence being considered sufficient I set a 12"x12"x12" with brick bat underneath where charred remnants of stake were found, for cor. to sec's 33, 34, 27 & 28. Hence West on true line

115.76 Set rock 9"x12"x21" with glass bottle underneath. I next proceeded to the quarter corner between sections 33 and 34 and find mound and pits of original corner in which I place a rock 6"x9"x3" the rock is a sharply pointed one.

Having the four quarter corners established on the North, South, East and West sides of the section I drew straight lines between the opposite quarter section corners and established a corner at their intersection by setting a rock 11"x11"x19" with brick bat underneath it for a quarter section corner at the center of section 33

W. L. Chalk County Surveyor
by P. Zahner Dep't.