

PLAT AND RECORD OF SURVEY No. 68-19

By Request of Frank Short Jan 3 1875

Acres
Degrees Minutes
Chains
Links

J 1 S R 35 E

I commenced at the corner to
Secs 10-11-14 and 15

which is a Post
from which

to Sec 11 in dia to $N 45^{\circ} W 25$ lbs dist


thence 15 " " " $N 35^{\circ} E 37$ " "

" 12 " " " $S 85^{\circ} E 25$ " "

thence 15 " " " $S 15^{\circ} W 17$ " "

thence west bet Secs 10 & 15

or $24^{\circ} E$

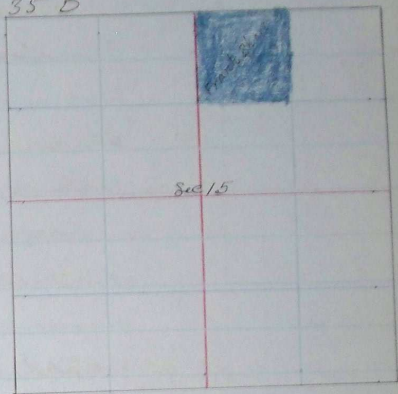

4 70 O R 8 N R 6 E N 8 S

10 75 Meacham creek runs North

40 20 the $\frac{1}{4}$ Sec cor bet Secs 11 & 15 Post destroyed reset Post marked 48
from which

a fir 10 in dia to $N 15^{\circ} E 29$ lbs dist

a Sander 15 " " " $S 50^{\circ} E 7$ " "

thence I ran South through center Sec 15

or $20^{\circ} E$

20 00 Set temporary $\frac{1}{16}$ cor for center $N \frac{1}{2}$ Sec 15

40 00 Set temporary $\frac{1}{16}$ cor for center Sec 15

60 50 Set temporary $\frac{1}{16}$ cor for center $S \frac{1}{2}$ Sec 15

80 50 I marked 90 lbs west of the $\frac{1}{4}$ Sec cor bet Sec 15 & 22

$N 0.37^{\circ} W$ on true line

20 $\frac{1}{16}$ Set Post marked $\frac{1}{16}$ for center of the $S \frac{1}{2}$ Sec 15

John W. K. Cimbale

County Surveyor