


PLAT AND RECORD OF SURVEY No. 70

Surveyed for Adam Leachhart Feb the 6 1895

J 2 N 63 0 E W 110

Leachhart me ~~Leachhart~~ ~~Leachhart~~
August ~~Leachhart~~
from Leachhart ~~Leachhart~~

Commenced at the 1/4 sec corner
bet Sec 8 and 9 the old stake was
down near by the old mound and
its plainly visible
thence I run N 41° 45' E
8 and 9

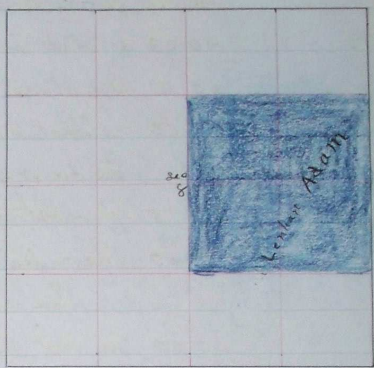

var 19° 45' E

- 6 50 descend steep bluff
- 12 50 foot of steep bluff descend gradually
- 14 50 wagon road N W 1/4 S E
- 17 50 Rail Road 0.85 N E 1/4 W
- 18 50 foot of hill enter umatilla bottom
- 19 40 Stone claimed by mr McCallum to be the corner
- 20 50 set temporary 1/4 corner
- 38 18 Bank of the umatilla river course N W
I send a flag on line across river and measure a base
west 200 links and set up instrument and find that
I have an angle of N 69° 19' E to flag from base
making distance across river 528 1/2 lks
- 38 43 1/2 Right on North bank of river
- 40 50 found no trace of Sec 8 as the river had changed its
channel and washed corner and witness trees away,
- 40 50 an abrupt cliff of rocks about 20 feet high which I had observed
and had sent a flag on top of bluff on line and from
my 200 lks base as previously stated find that I have
an angle of N 76° 45' E from base making the distance from south
bank of river 849 lks
- 41 67 Top of bluff on four course S W
- 49 50 Gulch course N W
- 41 12 Intersect 12 lks East of the 1/4 Sec 8 bet Sec 4 & 5
found the point of stake mound & the rocks set Stone 18 x 14 x 8 for 1/4 Sec 8



Hence S 05' E on true line

- 40 06 Set Stake in edge of bed of water at Corner Point for Sec 4-5-889
60 18 Set Stone 20x12x8 for $\frac{1}{16}$ corner

Hence N 88° 10' W from true N 88 line for Sec 5-889

to a flag pole set for corner in center of N $\frac{1}{2}$ Sec 8

which is a right from this $\frac{1}{16}$ corner and claimed to be

- 7 50 leave unattached more bottom NW $\frac{1}{4}$ Sec 8
8 28 O.P. & N P.P. NW $\frac{1}{4}$ Sec 8
9 50 Wagon Road NW $\frac{1}{4}$ Sec 8
14 25 same " SW $\frac{1}{4}$ Sec 8
15 50 " " NW $\frac{1}{4}$ Sec 8

17 50 Gulch course NE

25 50 Ridge N E

31 10 Gulch N 80° E

35 50 Point of ridge course south

37 50 head of gulch S E

40 37 Intersect true North-South line through center Sec 8

118 lbs North of $\frac{1}{16}$ corner point as I find by starting at the $\frac{1}{16}$ corner on north by Sec 8 and running South 2000

the same as the East by of Sec 8 set Sec 8-889 which I know and explain to all Parties in Interest is not correct, but they agree as the land is valuable outside of the river bottom 3300 chains they will not have the Sec subdivided as the Law requires,

from this point in center N $\frac{1}{2}$ Sec 8 to the $\frac{1}{16}$ corner on the line between Sec 8-889

S 89° 47' E on true line through center N $\frac{1}{2}$ Sec 8

John W. Coanbell

County Surveyor

Course