


PLAT AND RECORD OF SURVEY No. 82

Course. Degrees. Minutes. Chains. Links.

Surveyed for Mrs Louisa Bennett Apr. the 15th 1876

T. 5. N. R. 35. E. W. M.

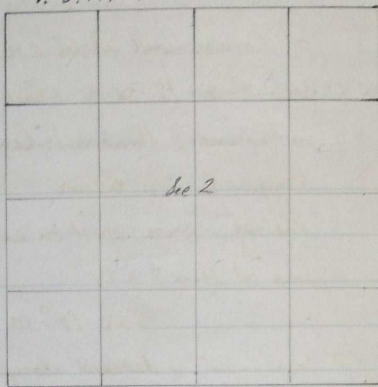

I Commenced at a Point 4 $\frac{3}{4}$ chains North and
72 $\frac{5}{8}$ chains East of the 44 sec corner between Secs
2 & 3 in T 5 N R 35 E W M. Hence I run

125 East

863 $\frac{1}{2}$ North136 $\frac{1}{4}$ N 66° 40' W

890 South to Place of Beginning

John W. Kimbrell County Surveyor