


PLAT AND RECORD OF SURVEY No. 88

Armstrong Bros Feb. 15 1897

Surveyed by order of Circuit Court

Section 11 Township 2 North Range 32 E. 9th W.

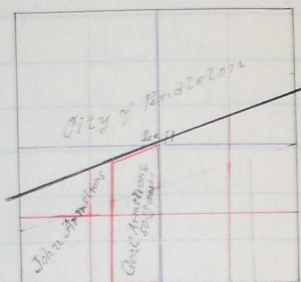

Commenced at the corner of Secs 10-11-14 & 15
 thence 5000 East on random line bet Secs 11 & 14
 $\text{Az } 21^{\circ} 15' \text{ E}$

26 52 Let Temporary fractional corner

40 00 thence to the corner bet Secs 11 & 14

thence west on true line

13 45 Let Stone 10 x 7 x 16 marked F.C. No 1 any place S. E. 1/4 Sec 11

thence North through D. 3/4 Sec 11

34 05 Intersect Reservation line or Reservation add for location

Let Stone 18 x 6 x 4 marked F.C. No 2

thence N. 68° 24' E

14 18 To further corner thence East - 157' due to N. E. Sec bet 11 & 14

thence South

40 00 to the corner on bet Secs 11 & 14 making 50 acres of plat

for George C. Armstrong

John W. Kimball County Surveyor

witnessed by


