


PLAT AND RECORD OF SURVEY No. 9219

By Court of C. B. Wade For 1st National Bank of Lindleton, Colo.

Course. Degree. Minutes. Chains. Links.

June 9th 1877
In T. R. N. R. 31. E. W. M.

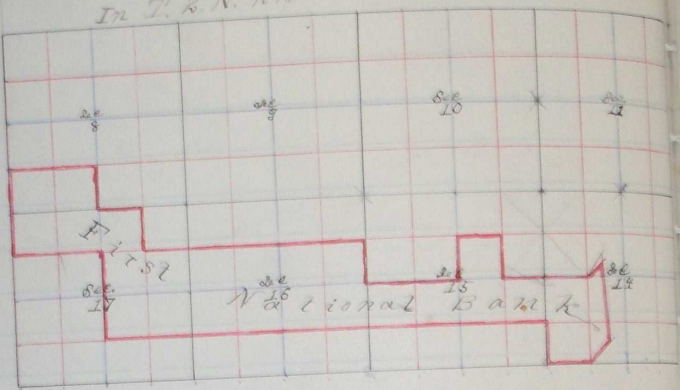

Commenced at the corner to Sec 9-10-15 1/16
which is the old cor. bet in ground of Stone
thence I ran East on random line bet Sec 10 1/16 -
10 24° 30' E

- 4 25 var 16° 30' E
- 10 50 could find no trace of the 1/4 sec cor bet temporary cor
- 42 75 dry gulch course south
- 57 04 foot of rock cliff 10 feet high course N 8 E
- 52 00 1/2 of ridge course south
- 65 50 old road N 8 S
- 67 75 New road 1/2 grade N 8 S
- 72 25 gulch course south
- 80 50 could find no trace of the cor bet temporary cor
thence I ran random line bet Sec 11 1/16
- 3 50 gulch S 15° E
- 11 70 1/2 of 1/4 sec course south
- 10 50 gulch course S 10° W
- 24 50 old road N 8 S
- 55 15 second cliff of rock
- 87 50 foot of cliff onto river bottom N 8 S
- 41 52 subject was the 1/4 sec cor bet Sec 11 1/16
which on exam of 1/2 sec in the corner of gulch

Time
Degrees Minutes
Chains
Links

- I then commenced at the house on lot nos 10 & 11 which is to the original plat in the name of Stone
- then I run south on random line lot nos 10 & 11
- 5 75 gulch course 8 22 - 79 3' 7 1/2"
- 24 50 " " 3 29
- 32 50 same gulch west fork - course 3
- 39 28 Intersect. of the East of my first Survey Stake placed Dec 10-11-1815
- 40 50 Set Survey peg cor. and run on South lot nos 14 & 15 -
- 41 50 ^{Set Survey 1/16 cor.} Could find no trace of 1/4 near set survey cor.
- 44 75 enter river bottom - enter field
- 47 50 O to V hole course 3 1/2 22
- 57 25 leave field to NW
- 60 50 Set Survey 1/16 cor.
- 61 50 ^{Set Survey 1/16 cor. on E side and find angle 50 25' before = 120 6' + 61 0' = 720 6' + 62 0' = 77 21'}
- 64 50 North bank of Umatilla river bed runs west -
- 65 32 North edge of water in river.
- 73 06 26 ft high cliff 401 feet high by triangulation from north side
- 79 81 In the corner of lots 14-15-22 & 23 old plat in and base
- There north on line marked lot nos 14 & 15 -
- 17 87 Set Stone in NW of Stone for 1/16 cor.
- 39 77 Set Stone marked 114 in and North and Stone to the NW
- 57 66 Set Stone for 1/16 corner in NW of Stone & South NW 1/16
- 17 54 Set Stone 22 + 6 1/2 - 6 for cor. to lot nos 10-11-14 & 15 -
- then west on line marked lot nos 10 & 15 -
- 40 38 Set Stone for 1/16 for cor. lot nos 10 & 15 with the 1/16
- 50 75 the cor. to lot nos 9-10-15 & 16
- then south on random line lot nos 15 & 16
- for 28' 30" S
- 20 17 Set Survey 1/16 cor.
- 26 25 Point of bluff 3 1/2 W
- 27 75 O to S NW 1/16 3 1/2 W
- 28 50 Umatilla river runs west -
- 3 00 3 left bank -

Chains Links

74 33 right bank umatilla river runs north 440 lbs road
 80 60 intersect 206 lbs north of 1/4 sec cor bet Sec 15 & 16
 Run N 88° 31' E on true line through center Sec 15

From the 1/4 sec cor bet Sec 10 & 11 -
 I run south on true line through center Sec 11 -
 Nor 20° 30' E

17 55 edge of rock
 20 10 bet Survey 1/16 corner
 28 07 gulch 1/2 E
 38 12 run on warehouse at Boardman Station
 34 55 O B & N 106 B & W -
 39 70 intersect true E & W line through center Sec 15 - at top of 256
 59 48 right bank umatilla river 193 lbs side runs west
 60 50 bet Survey 1/16 corner
 79 41 intersect the 1/4 sec cor bet Sec 15 & 2 -
 Run north on true line
 1490 bet Stone for 1/16 cor bet center 8 1/2 sec 15 -
 37 80 bet " " " " center Sec 15 -
 59 65 bet Stone in mid of Stone for 1/16 cor center N 1/2 Sec 15 -
 these East
 20 18 bet Stone for center N 1/4 Sec 15

From the 1/4 Sec cor bet Sec 14 & 15 -

I run east on random line through center Sec 14

3 50 Road S 5 1/2 NW
 4 50 " " " "
 15 00 gulch runs south
 20 00 bet Survey 1/16 corner
 24 75 O B & N 106 S W & N E
 29 70 through or old channel of umatilla river runs south

Course.	Degrees.	Minutes.	Chains.	Links.
---------	----------	----------	---------	--------

- 3890 Umatiche river runs South
 4050 Intersect same N & S line through center sec 16-
 4160 foot of Hill N & S
 5019 Intersect 128 lbs South of the $\frac{1}{4}$ sec cor bet sec 13 & 14
 S $89^{\circ} 5'$ W on same line through center sec 16-
 3754 center sec 15-
 5979 1st Stone 24 + 15 + 4 for $\frac{1}{16}$ corner in center of $\frac{1}{2}$ sec 14
 These 3 run South from Center S $W \frac{1}{4}$ sec 14 for 25
 Purpose of Establishing a 30 acre tract in $6\frac{1}{2}$ of $W \frac{1}{4}$ here
 200 foot of Hill S $W \frac{1}{4}$ N 8°
 693 Old S $N 66^{\circ} 8'$ W $N 8^{\circ}$
 850 ditch course S W
 1360 Slough runs W 166 lbs across
 1740 Umatiche river 70 + lbs across runs West
 2010 1st Stone for the corner on bar in slough of river
 2815 foot of Steep bluff S W
 2971 foot of cliff marks face of cliff $\frac{1}{4}$ cor between cor. the two
 corner being 9 lbs South of point and inaccessible
 These $N 45^{\circ} E$ on offset NW from line
 320 foot of Steep hill S W
 591 a cottonwood 24 in dia on same line marks the 2000
 950 Umatiche river 420 lbs wide runs NW
 1850 1st Stone for fractional cor from the
 a cottonwood 10 inches $N 88^{\circ} 5'$ 14 lbs dist
 " " " to $N 25^{\circ} W$ 12 "
 These $N 10^{\circ} W$
 272 Umatiche river course S $80^{\circ} E$ 500 lbs to left bank
 1250 lower end of Slough on old channel these are Slough
 2150 1st willow Stake for N 6 cor of 30 acre tract in Slough
 These $S 60^{\circ} W$
 1050 to $\frac{1}{16}$ corner in center of $\frac{1}{2}$ sec 14 and to place of sign

PLAT AND RECORD OF SURVEY No. 1419

Links.

- From the corner to Dec 7-10-15 & 16
 Run west on random line bet Dec 7 & 16
 $\text{Az } 240^{\circ} 6$
- 12 50 gulch course $810^{\circ} 6$
 28 50 old trail NW $8^{\circ} 5$
 37 50 Intersect 32 lts south of stage 1/4 sec which is original
 stake in mid of Stone
 57 50 gulch course South
 79 25 cross head of drain east $810^{\circ} 6$
 85 17 The corner to Dec 8-9-16 & 17 bet Stone in mid of Stone
 Run west on random line bet Dec 8 & 17
- 20 11 bet Tempory '116 corner
 29 65 gulch run SW
 39 50 Old $8^{\circ} 15$ to $8^{\circ} 5$ NW
 40 00 End of line NW 1/4 sec
 48 76 Unatilla river 140 lts across runs north
 46 96 Top of bluff 10 feet high west W sec 5
 68 10 Unatilla river 229 lts across runs SW
 79 80 corner not visible set survey on fence to Dec 7-8-17 & 18 on fence
 line NW $8^{\circ} 5$ said to be line

From the original corner to Dec 17-18-19 & 20
 which is Post in mound of Stone
 Run north bet Dec 17 & 18

 $\text{Az } 22^{\circ} 5$

- 39 57 Intersect 1/4 sec corner bet Dec 17 & 18
 59 57 bet Tempory '116 corner
 74 28 Unatilla river 262 lts across
 80 65 Intersect Tempory corner previously bet on 6 & 7
 These north bet Dec 18 & 19
- 39 3 bail track NW $80^{\circ} 6$
 50 road along East side of ridge line south

PLAT AND RECORD OF SURVEY No. 7119

Course	Degrees	Minutes	Chains	Links
--------	---------	---------	--------	-------

- 20 10 Set Survey to corner
- 40 55 Could find pt. by line corner, extend line 100 ft
- 50 05 Intersect old corner to line 50-788 at
Intersection of wire fence N 48 S a road
Here look on same line set line 788
- 60 52 Set Stone in mound of Stone for corner
- 80 00 Set Stone 16x8x6 in mound of Stone for corner
from which
a cottonwood 2 in dia N 27° W 17 1/2 ft
" " " N 26° S 24 " "
- This point set line 17 1/2 ft
- 4 75 River runs west
- 20 55 Set post in mound of Earth with line N 88 S plain
South on temporary line set line 16 1/2 ft
- 18 50 Rivine
- 20 55 Set Survey to corner
- 35 50 foot of Hill
- 36 05 Paul Creek S 8 W
- 40 55 Could find No 4 line set Survey to corner
- 45 78 Unlikely River runs west
- 61 52 Set Survey to corner
- 71 42 Intersect old line west of the old corner
Here No 24 W on same line
- 11 50 Set Stone in mound for corner
- 31 71 Set Stone 24x12x6 for corner in mound of Stone
- 57 58 Set Stone in mound for the corner
These west from this corner
- 21 55 Set Stone for the corner in mound of earth
- 39 55 Set Witness corner for the corner. On east bank of
Unlikely river as true corner would be in River

PLAT AND RECORD OF SURVEY No. PLAT

Dist.	Degrees	Minutes	Chains	Links
				From the 1/4 Sec corner lot Secs 17 & 18 -
				Run East on True line through center of 17
40				Set 1st stone for center Sec 17
				Then South on parallel line through center of 17
21				Set 2nd stone 116 corner
37				Intersect old corner - double line by 105 1/2 c
				Then north on true line
19				Set Stone 25 x 4.5 ft - 116 corner

From the 1/4 Sec corner lot Secs 8 & 17
 Run East on Railroad Embankment 20 feet from track
 Run East
 20 00 Set Stone in ground for 116 corner in center of Sec 8 -

From the 116 corner on East Boundary of 1/4 Sec 17
 Run West through 1/4 Sec 16 on double line
 20 00 Set 1st stone 116 corner
 40 00 Set " " 116 corner
 60 00 Set " " 116 corner
 79 14 Intersect 72 1/2 c South of the 116 corner on East Boundary
 S 89° 29' E on true line
 19 78 Set Stone for 116 corner
 39 57 Set Stone in ground of Stone in Subst. road North
 59 36 Set Stone in line of South for 116 corner
 79 14 The 116 corner

John Whitcomb County Surveyor
 Assisted by Mr. Bert Ferguson and
 Ed McFadden and Will Johnson Chainmen
 who were each duly Qualified before entering upon
 their duties as such