


PLAT AND RECORD OF SURVEY No. 108

Survey for S. M. Bixby June 6 1899

1/4 Sec 4 S 16 30 E 7 1/4

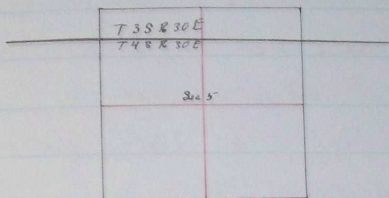

I commence at the cor to Sec 5-6-7-8 &
 thence east on random line bet Sec 5-8
 $\text{Voz } 23^{\circ} 6'$

40 00 Set temporary 1/4 Sec cor to trace of original

60 00 " " 1/16 cor

80 37 Intersect 24 1/2 South of cor to Sec 4-5-8-9
 thence $\text{S } 89^{\circ} 50' \text{ W}$ on true line

20 28 Set stake in mid of Stone for 1/16 cor

40 15 Set Stone in mid of Stone for 1/4 Sec cor

West through center Sec 5 $\text{Voz } 23^{\circ} 8'$

20 00 Set temporary 1/16 cor for center 1/4 Sec -

40 00 " " 1/16 cor for center Sec 5 -

79 98 the 1/4 Sec cor bet Sec 5-8-6

thence North

39 78 Intersect 115 1/2 West of CC for Sec 5-8-6

thence East along Sp line on North side Sec 5 -

6 32 the Standard cor for Sec 31-4-32

40 00 Set temporary 1/4 Sec corner

47 00 the Standard 1/4 Sec cor for Sec 32

80 38 the CC for Sec 4-8-5 - use at 87 53 the Standard cor for Sec 4-8-5

thence West on North side Sec 5 -

140 19 Set Stone 27 + 14 + 10 marked 1/4 on S side for CC to Sec 5 -

thence South through Sec 5 -

8 76 Set Stone 20 + 8 + 5 for 1/16 corner in center of Sec 5 -

29 53 True S & W line Set Stone 16 + 8 + 4 for center Sec 5 -

49 53 Set Stone for 1/16 cor center S to Sec 5 -



69 85 the 1/4 sec cor bet sec 5 & 8

From the 1/4 sec cor bet sec 4 & 5 - 9 run

North bet sec 4 & 5

27 14 intersect 22 lls west of ccty. sec 4 & 5 -

2018' W on same line

7 15 set Stone in mid of Stone for 1/4 c.

From the 1/4 cor on S ldy S 8 1/4 Sec 5 -

I run North through center S 8 1/4 Sec 5 -

40 10 the 1/4 cor in center S l - Sec 5 - set Stone 10+6+5


the 1/4 South on same line

20 05 set Stone 14+7+5 for 1/4 cor - Center S 8 1/4 Sec 5 -

Geo. L. Horseman and James Hall chainmen
 A. H. Mulkey, Hogman

John W. Kimball County Surveyor

Scherder -

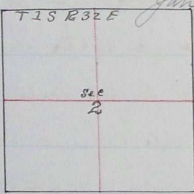June 13th 1899 T 1 S 16 32 E 29mNov 21st

I commenced at ccty. sec 2 & 3 and run East on base line in N 1/2 sec 2

15 95 the standard cor for sec 34 & 35 -

20 05 set corner 1/4 cor ccty

40 50 set corner 1/4 cor ccty

55 93 the standard 1/4 cor on base line -

65 05 set corner 1/4 cor ccty

81 11 the ccty. sec 1 & 2

the 1/4 South bet sec 1 & 2

39 98 the 1/4 cor on bet sec 1 & 2

79 93 set corner ccty for sec 1-2-11 & 12

these work on ^{North} True line

20 05 set stake for 1/4 cor