


PLAT AND RECORD OF SURVEY No. 113

Geo. Ely and A. B. Portlock Nov. 2nd 1899

Course. Degrees. Minutes. Chains. Links.

in T3N R33 E W M

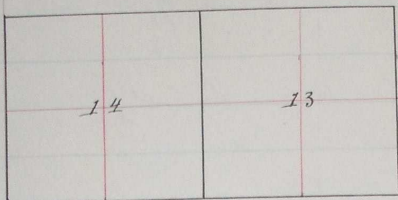

I commenced at the 1/4 sec cor bet Secs 11 and 14
thence 1/4 mi East bet Secs 11 & 14

39 94 the cor to Secs 11-12-13 & 14

thence South bet Secs 13 & 14


40 00 bet temporary 1/4 sec cor

80 27 the cor of Secs 13-14-23 & 24

thence North on true line

40 28 1/2 bet Stone 22 + 8 + 6 for 1/4 sec cor

John W. Turnbull County Surveyor

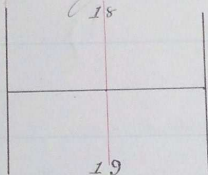

No 114

Surveyed for J. Reed and Wm. Williams

Nov 8th 1899 in T3N R36 E W M

I commenced at the 1/4 sec cor bet Secs 17 & 19 and thence
East bet Secs 18 & 19

37 80 thence 208 lks North of cor to Secs 17-18-19 & 20

thence N87°31'W on true line

18 65 bet Stone for 1/4 sec cor

John W. Turnbull County Surveyor