


PLAT AND RECORD OF SURVEY No. 1151

Ernest Grosschmiz Jan 1st 1900

in S 1 N E 31 E W 1/4

Degrees Minutes Chains Links

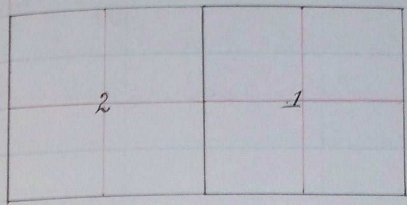

I commenced at the cor of Secs 1-2-11 & 12
thence north bet Secs 1 & 2

40 00 set temporary 1/4 Sec cor

80 82 bore seat North bdy 80 lks W of cor Sec 1-2-35 & 36

thence 4 m S 0 24' W on true line

40 86 set Stone 24 + 16 + 10 for 4, 100 ea in mid of Stone

80 82 to cor Secs 1-2-11 & 12

John W. Kimball County Surveyor