


Surveyed for Wm. Temple

Rebate made a.c. friendly January 24<sup>th</sup> 1900

Course Degree Minutes Chain Links

13 N. 63 1/2 E. 11.00

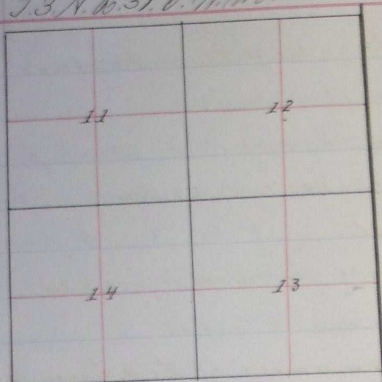

For the purpose of establishing the lines bet Secs 11 & 14 and 12 & 13

I commenced at the acknowledged corner to Secs 10-11-14 & 12  
which is indicated by a stone in Road running N 42° E  
thence I ran East on Random line bet Secs 11 and 14

39 92 as indicated by original field notes of Government Survey  
I set temporary 1/4 Sec corner

79 50 wire fence run N 42° E

79 84 set temporary cor for Secs 11-12-13 & 14  
thence West extend same line

40 18 set temporary 1/4 Sec cor bet Secs 12 & 13

80 36 as indicated by original field notes could find no  
trace of cor for Secs 12-13-7 and 18 on Range line  
I set temporary cor at this point, and ran  
to the acknowledged corner of Secs 14-19-13 and 24  
and ran North on Range line bet Secs 13 and 18

80 08 set temporary cor for Secs 7-18-12 & 13  
thence North bet Secs 7 & 12

40 73 the acknowledged 1/4 Sec corner bet Secs 7 & 12  
thence I ran South on same line

40 24 set stone for cor Secs 7-12-13 and 18 in field which is  
at a point 312 lks South and 62 lks East of my temporary 1/4 Sec  
making an excess of 82 lks in the line bet Secs 11-14-13  
over to original field notes of Government Survey.

I therefore divide this 82.160 excess bet the whole dist run  
 these west

40 39 Set stake for 1/4 Sec 200

80 78 Point for cor Secs 11-12-13 & 14  
 these west

40 12 Set stake for 1/4 Sec cor bet Secs 11 & 14

80 24 to cor Sec 10-11-14 & 15

I then commenced at the Acknowledged 1/4 Sec cor  
 bet Secs 11 & 12 and run South bet Secs 11 & 12

11 45 norine course N 80° W

40 07 Set temporary cor for Secs 11-12-13 & 14

80 54 to fence E & W which is the undisputed line. E & W through  
 center of 13 and 14 corners for the satisfaction of myself  
 and Mr. Friendly and Roberts & Temple I extended my  
 line South bet Secs 13 & 14

40 25 The corner of Secs 13-14-23 & 24 in center of Board  
 running E & W and accepted as the line

I therefore set stake at Point for Secs 11-12-13 & 14  
 as agreed by all Parties in interest that they would  
 plant a rock themselves as it is right and no  
 more handy and we could not do it this evening  
 and we to go to Cavalleton the next morning.

John W. Kimball County Surveyor  
 Roberts and Wm. Temple Chairman } by mutual  
 A. C. Friendly, S. J. G. } agreement