


PLAT AND RECORD OF SURVEY No. 118-19

J. N. Swate and Elmer Bugg. March 13th 1900

Course. Degrees. Minutes. Chains. Links.

S 13 R 30 E W 111

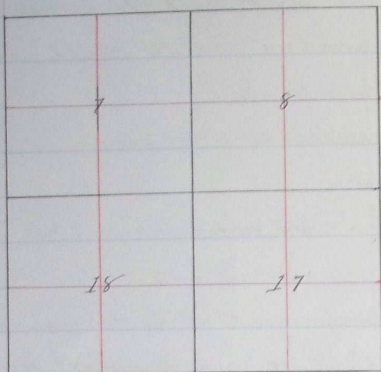

I commenced at the corner of Sec 7-8-17 & 18
which is the original Stone in end of Horse

Thence I ran East on random line bet. Sec 8 & 17

N 20° 15' E

- 3 20 better creek 69 lbs wide course N 5
- 40 00 could find no trace of 1/4 Sec corner bet. Sec 8 & 17
- 52 50 Top of ridge course South
- 60 00 bet. Sec 8 & 17 1/4 Sec.
- 67 00 Gulch course South
- 82 65 Undercut 118 lbs North of ca. bet. Sec 8-9-16 & 17
- Thence I ran
N 89° 11' W on true line
- 20 64 bet. bet. for 1/4 Sec
- 41 67 bet. original Stone for 1/4 Sec. bet. Sec 8 & 17 in end of Horse
- Thence I ran South on random line through cut. bet. 17
- 20 00 bet. Sec 8 & 17 1/4 Sec. cut. N 42° Sec 17
- 21 10 better creek 141 lbs to spot. bluff on S. side
- 22 51 Top of bank on left bank
- 40 00 bet. Sec 8 & 17 1/4 Sec. cut. Sec 17
- 80 92 Undercut 75 lbs West of the 1/4 Sec. bet. Sec 17 & 20
- N 64° 30' E on true line
- 40 66 the cut. Sec 17
- 60 82 the 1/4 Sec. cut. N 42° Sec 17

Acres. Meters. Chains. Links.

From the cor sec 7-8-17 & 18 1/2 acre
 South on random line bet sec 17 & 18 var $20^{\circ}15'5''$
 21 13 bet temporary 1/16 acre
 40 28 intersect 21 lbs east of 1/4 sec cor bet sec 17 & 18
 these 1/2 acre
 No 20' 3" on true line
 20 14 bet stone 18 x 8 x 6 ft 1/16 acre
 40 28 the cor sec 7-8-17 & 18
 From the 1/4 sec cor bet sec 17 & 18 1/2 acre
 East on random line ~~bet sec~~ center sec 17
 var $19^{\circ}5''$
 40 74 intersect true N & S line
 81 60 " 52 lbs N of 1/4 sec cor bet sec 16 & 17
 these 1/2 acre
 N $89^{\circ}57'$ W on true line
 40 89 the center sec 17
 John W. Simbell County Surveyor