


PLAT AND RECORD OF SURVEY No. 125

For C A Barrett

June 11 1900

T 5 N R 35 S W 30

Assisted by Jewell Bramblet Flyman
Floyd Anderson Chairman
S. W. Titsworth

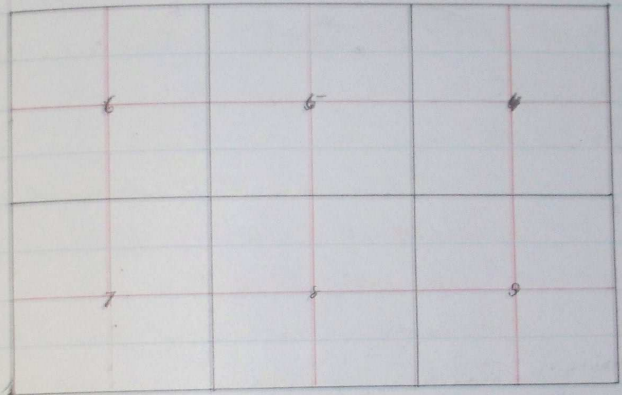

I commenced at the cor of Sec 7-12-13 & 14 on
 range line between Towns 34 & 35 Tps 5 N 10 W
 Thence South on range line between 13 & 14
 40 00 could find no trace of 4 Sec cor
 50 27 1/2 interest cor. to Secs 15-19-13 & 24
 thence East on true line
 40 14 set Stone 15 x 2 x 14 sp 1/4 Sec cor
 East on Roubidoux line bet Secs 14 & 19
 29 60 set Survey 1/4 Sec cor in field of wheat
 54 50 Pine Creek runs North
 79 60 could find no trace of cor Secs 15-19-13 & 24
 set Survey cor
 80 00 the cor Secs 16-17-20 & 21

East bet Secs 7 & 18
 110 00 set Survey 1/4 Sec cor
 118 25 Pine Creek runs N
 79 50 set Survey cor bet Secs 7-8-17 & 18
 could find no trace of Sec cor

Course.	Degrees.	Minutes.	Chains.	Links.
---------	----------	----------	---------	--------

Thence East bet Secs 2 & 17

39 75 Intersect 530 lbs North of $\frac{1}{4}$ Sec cor bet Secs 2 & 17
South bet Secs 5 & 6

29 90 Set Temporary $\frac{1}{4}$ Sec cor could find no trace of old cor.

79 90 could find no trace of cor Secs 5-6-7 & 8

and Set Temporary cor

thence South bet Secs 7 & 8

40 00 Set Temporary $\frac{1}{4}$ Sec cor

80 00 Set Temporary cor 808 & 100 W of first stake

thence South bet Secs 17 & 18

40 00 Set Temporary $\frac{1}{4}$ Sec cor

79 85 Intersect 157 lbs W of first stake at cor

on E & W line

thence South bet Secs 29 & 30

78 37 Intersect 166 lbs west of cor Secs 11-20-29 & 30

thence North bet Secs 18 & 20

79 60 Set Stone in mound for cor Secs 19-20-29 & 30

thence North bet Secs 17 & 18

39 80 Set Stone in mid of Stone for $\frac{1}{4}$ Sec cor

79 60 Set Stone 22 + 10 + 6 for cor Secs 17-18-19 & 20

thence North bet Secs 7 & 8

39 80 Set Stone for $\frac{1}{4}$ Sec cor bet Secs 18 & 19

79 60 Set Stone for cor bet Secs 6-7-17 & 18

thence North through center Sec 18

79 60 the $\frac{1}{4}$ Sec cor

John W. Timber
County Surveyor