


PLAT AND RECORD OF SURVEY No. 13079

Survey made at request of Farmer Banks Walla Walla

Feb 4/1902

Course. Degree. Minutes. Chains. Links.

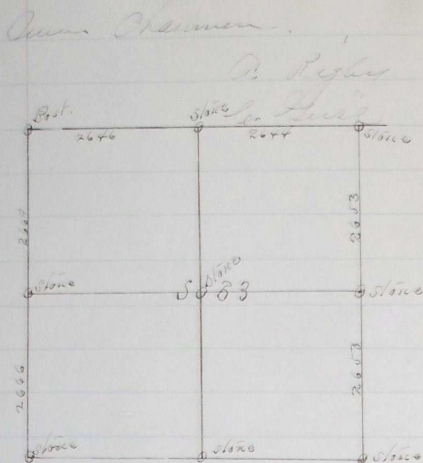

Beginning at Cor to Sec 33-34-27-28.

Th 3 N R 35 E. 27 N. Thence

on true line between Sec 33 & 34.

53 06 Set Stone 15x8x6 to mark Sec Cor 33 & 34
on 7/8 line of reservation and
at 1/2 distance reestablished 1/4 Sec Cor
by setting Stone 14x6x8. Thence
on South line of Sec 33.

52 98. The corner to Sec 32 and 33 a old stake
which I replaced with a ^{stone} stone and buried of
charred stake underneath. at 1/2 distance
2649 I set Stone for 1/4 Sec Cor with stone
6x8x15, marked 1/4

I return to Cor of Sec 33 34 27 & 28. and
on true line bet Sec 28 & 33.

26 44 Set 1/4 Sec Cor

52 90 The cor to Sec 28, 29, 32 & 33 Thence
on west line of Sec 33

26 69. 1/4 Sec Cor a charred stake 20 links
replace with Stone 20x16x16

South

West

Run West

South

Degrees Minutes Chains Links

33 35 Three South
 The cor. to Sec 32 & 33.
 I placed flags at all the four 1/4
 Sec. corners and from them intersected
 the North and South and East and West
 center lines of Sec 33. and set
 Stone 14 x 8 x 8 for center of Section.
 Le E. W. Beaulieu
 County Surveyor.