

Surveyed for John Obryant May the 30 1890
by J.W. Kimball county surveyor Plat No. 112

T 6 S 16 38 E W M

I commenced at
the corner to Sec.

1-12-6 & 7
on Range Line
bet Sec 38 & 39

Township 6, S,
Thence North bet.
Sec 1 & 6

Var 20° E

20 00 Set temporary 1/16 corner

40 06 Intersect 16 lles
East of the 1/4 Sec cor.
bet Sec 1, 8, 6

Thence S. 14' E
on line line

20 03 Set post for 1/16 corner 7812

40 06 ~~The corner to Sec 1 & 6~~
I commenced at the 1/4 Sec corner bet Sec 1 & 6
thence west through the center Sec 1
Var 20° E

20 00 Set temporary 1/16 corner of center E 1/2 Sec 1

40 00 Set temporary 1/16 corner for center Sec 1

60 00 Set temporary 1/16 corner for center W 1/2 Sec 1

81 35 Intersect 5 3/4 lles North of the 1/4 Sec corner bet Sec 1 & 2
S 89° 38' E on line line

20 34 Set 1/16 corner for center W 1/2 Sec 1

40 68 Set 1/16 corner for center Sec 1

61 02 Set 1/16 corner for center E 1/2 Sec 1

81 35 The 1/4 Sec cor bet Sec 1 & 6
I commenced at the 1/4 Sec corner bet Sec 1 & 2
thence South 3° 30' E Var 20° S

20 00 Set temporary 1/16 corner

40 05 Intersect 10 lles E of the corner to Sec 2-11 & 12
J.W. Kimball county surveyor



Surveyed for R.L. Smith & Wilson Bros. June the 3rd 1890
by J.W. Kimball county surveyor Plat No 113

T. 6, S. 16, 39, E. W. M.

Commenced at the

Corner to Sec 29-30-31 & 32

Thence South bet Sec 31 & 32

Var 20° E

20 00 Set temporary 1/16 corner

31 00 Road E & W

31 85 Rail fence E & W

40 00 found No 1/4 Sec cor
and Set temporary
1/4 Sec corner

55 50 Rough runs East

58 53 North Powder River 127 lles wide runs East

60 00 Set temporary 1/16 corner

79 92 Intersect South boundary 6 lles East of the corner to Sec 29-30-31 & 32
Thence N. 1' E on line line bet Sec 31 & 32

19 98 Set post for 1/16 corner

39 96 Set Stone 18x7+6 inch for 1/4 Sec corner bet Sec 31 & 32

59 94 Set Stone 14x7+6 " " 1/16 corner

79 92 The corner to Sec 29-30-31 & 32

I commenced at the 1/4 Sec corner bet Sec 31 & 32
Thence East through center Sec 32
Var 20° E

40 12 The Center Sec 32

80 25 The 1/4 Sec corner bet Sec 32 & 33


I commenced at the 1/4 Sec corner bet Sec 29 & 32
Thence South through the center Sec 32
Var 20° E

800 Road E & W

2000 Set temporary 1/16 corner for center N 1/2 Sec 32

40 00 Set temporary 1/16 corner for center Sec 32

80 00 The 1/4 Sec corner bet Sec 5 & 32
Thence Run North and Set permanent corners
as indicated on My Random line

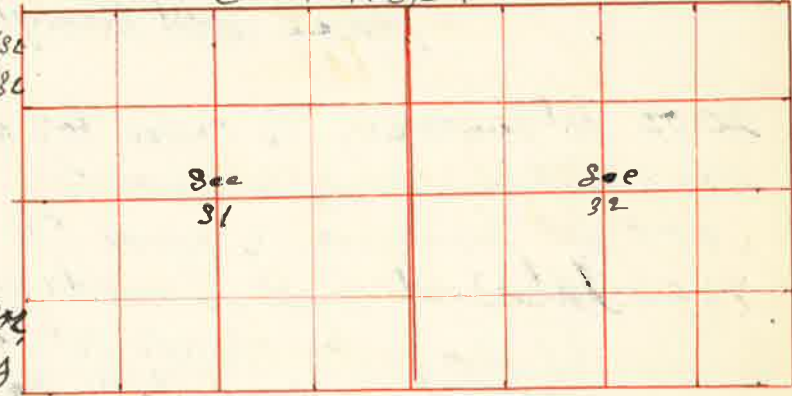

I commenced at the $\frac{1}{4}$ Sec corner bet Sec 31 & 32
 thence west through the center Sec 31
 Var $20^{\circ} 10' E$


- 20 00 Set temporary $\frac{1}{16}$ corner for center $E \frac{1}{2}$ Sec 31
- 40 00 Set temporary $\frac{1}{16}$ corner for center Sec 31
- 60 00 Set temporary $\frac{1}{16}$ corner for center $W \frac{1}{2}$ Sec 31
- 78 03 Intersect West Boundary of $\frac{1}{4}$ Sec 31 & 32
 of the $\frac{1}{4}$ Sec corner bet Sec 31 & 32
 which is in center of County Road E & W
 Post decayed I re-establish it by
 planting below the surface an old
 Cast Iron cog wheel 15 inches diameter
 with edge upwards facing E & W

J. W. Kimball
 County Surveyor

Surveyed for P. M. Coffin June 4th 1890
 one July 26 1891 Private Survey
 by J. W. Kimball County Surveyor Plat No. 114


- I commenced at the corner to Sec 2-3-34 & 35
 thence South bet Sec 2 & 3
 Var $20^{\circ} 8'$
- 19 80 Set temporary $\frac{1}{16}$ corner
- 40 07 Intersect $2 \frac{1}{2}$ miles East
 of the $\frac{1}{4}$ Sec corner
 bet Sec 2 & 3
 which is a mound
 bet the original corner
 thence $N 1^{\circ} E$ on
 true line
- 20 14 Set Post for $\frac{1}{16}$ corner
- 40 07 the corner
 the $\frac{1}{4}$ Sec corner
 bet Sec 2 & 3
 thence South bet
 Sec 2 & 3 var $20^{\circ} 8'$

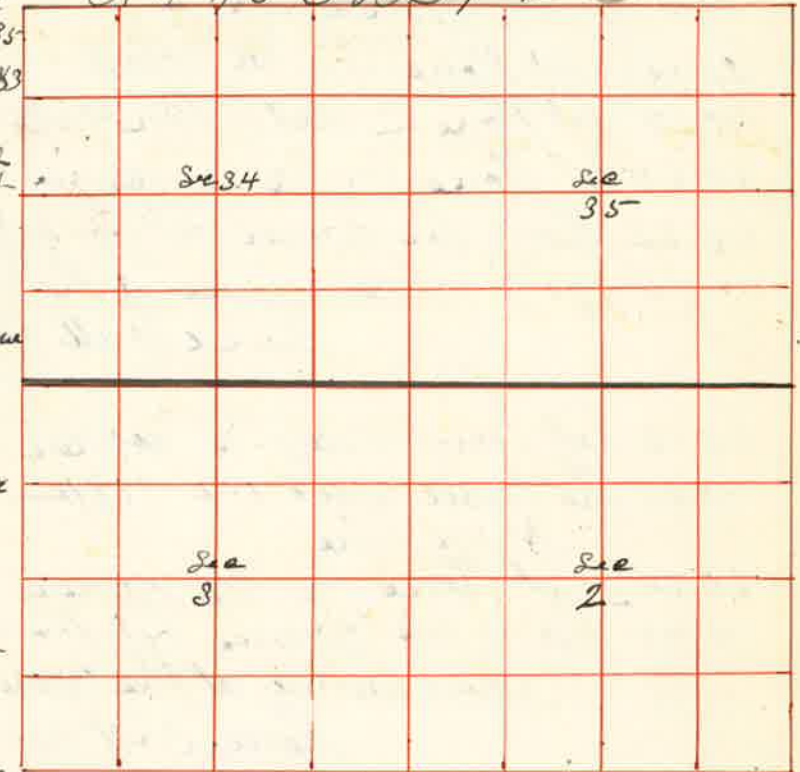

- 20 00 Set temporary $\frac{1}{16}$ corner
- 40 00 Intersect 92 lks West of the corner to Sec 2-3-10 & 11
 thence I ran $N 1^{\circ} 19' W$ on true line
- 20 00 Set Post in mound of Stone for $\frac{1}{16}$ corner
- 40 00 the $\frac{1}{4}$ Sec corner bet Sec 2 & 3
 thence East through center Sec 2
 Var $20^{\circ} 30' E$
- 40 00 Set temporary $\frac{1}{16}$ corner for center Sec 2
- 60 00 Set temporary $\frac{1}{16}$ corner for center $E \frac{1}{2}$ Sec 2
- 81 28 Intersect 85 lks South of the $\frac{1}{4}$ Sec corner bet Sec 1 & 2
 I therefore find the true course of this center
 E & W line to be $S 89^{\circ} 4' W$ and $N 89^{\circ} 4' E$
 I then commence at the $\frac{1}{4}$ Sec corner on N. $\frac{1}{2}$ Sec 2
 and run South through center Sec 2
 Var $20^{\circ} 8'$
- 20 00 Set temporary $\frac{1}{16}$ corner for center $N \frac{1}{2}$ Sec 2
- 39 85 Intersect true E & W line 85 lks West of the first stake
 at this point