

Surveyed for Frank Casick & Harry Burns May 20 1889
by W. Ferrinbell County Surveyor Plat No. 77

I Commenced at the corner
to Sec 14=15=22 & 23
Thence South var 20° E

2000 Set Post for Temporary 1/4 corner
4025 No 1/4 Sec corner bet Sec 22 & 23
from which I run North on Incline

2012 Set Stone 8x10x18 inch
4025 The Corners to Sec 14=15=22 & 23
The 1/4 Sec corner bet Sec 22 & 23
a Post in ground of Stone.
Thence East through to the
center Sec 23 var 19° E

2000 Set Post for Temporary 1/4 corner in
Center W 1/2 Sec 23

4000 Set Post for Temporary center Sec 23
7400 Summum Creek
7990 Intersect East Boundary But found no corner I therefore
proceeded to Re-establish it - by starting at the corner to
Sec. 13=14=23 & 24 and run South var 20° 30' E

1075 Spring Branch S E
1175 " S W

4000 Set Stake for Temporary 1/4 Sec corner
8000 found no Sec corner and Set Stake for temporary one to Sec 23=24=25 & 26
Thence South var 20° 15' E

4000 found no 1/4 Sec corner

8065 The corner to Sec. 25=26=35 & 36 Making an excess of 65
feet over US field notes I therefore run North on Incline

8082 Set Stake for corner to Sec. 23=24=25 & 26
Thence North var 20° 6'


4017 Set Post for 1/4 Sec corner 61 lks North of Intersection of E & W line
at this point
The 1/4 Sec corner on North Boundary Sec 23 Thence South

2000 Set Temporary 1/16 corner for center N 1/2 Sec 23

4019 Intersect E & W line 11 lks East of first Stake at this point

8030 Intersect South Boundary 82 lks East of 1/4 Sec. Corner bet Sec 23 & 24
from which I run North on true line through Center Sec 23

4611 The Center Sec 23

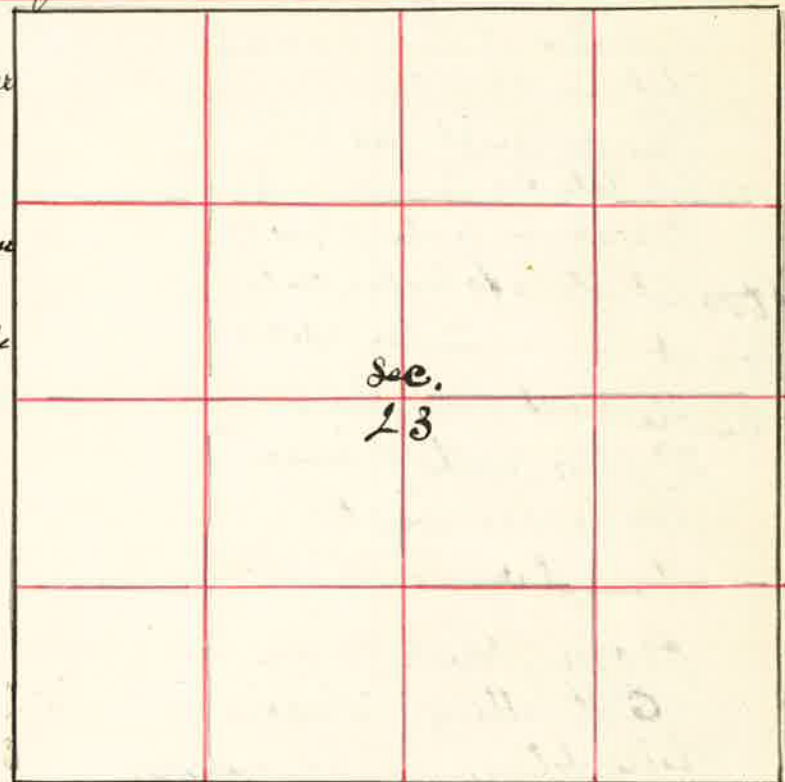

Surveyed for Frank Casick & Harry Burns May 20 1889

Thence North var 20° E
4025 Set Stake for center Sec 23
6019 the 1/4 Sec corner
6020 The center N 1/2 Sec 23
8080 North Boundary Sec 23 at 1/4 Sec corner bet Sec 14 & 23
The 1/4 Sec corner on East Boundary Sec 23
Thence West var 20° E

4012 The center Sec 23
6000 Set Stone 6x6x30 inches for Center W 1/2 Sec 23
7990 the 1/4 Sec corner on west side Sec 23
The 1/8 corner on west Boundary N W 1/4 Sec 23
Thence East var 20° 15' E

2000 Set Stone for 1/16 corner in Center N W 1/4 Sec 23

W. Ferrinbell
County Surveyor