

I Commenced at the $\frac{1}{4}$ Corner between Sec 23 & 26 from which a Pine 13 in brs N 57° E 44 lks " 22 " " S 67° E 68 "

Thence North through center Sec 23

972 Pine creek 229 lks wide S.E.

2000 Set Post for temporary $\frac{1}{16}$ corner in center $\frac{1}{2}$ Sec 23

4000 Set Stake for temporary center Sec 23

5500 Top of Ridge

8143 Intersect North boundary 102 lks East of $\frac{1}{4}$ Sec corner from which a Pine 18 in brs S 78 $\frac{1}{2}$ ° E 79 lks " 13 " " N 83° W 175 "

The $\frac{1}{4}$ Sec corner on East bdy Sec 23 or bet Sec 23 & 24 Thence West var 19° E

2000 Set Post for temporary $\frac{1}{16}$ corner in center $\frac{1}{2}$ Sec 23

3850 Intersect N $\frac{1}{2}$ S line 108 lks North of first Stake at this point

4000 Set Post for temporary center

5500 Pine creek runs S E

5685 " " runs S E

5850 " " " "

6000 Set temporary $\frac{1}{16}$ corner for center w $\frac{1}{2}$ Sec 23

8050 Intersect west boundary Sec 23 365 lks South of $\frac{1}{4}$ Sec corner from which a Pine 10 in brs N 12° W 128 lks " 13 " " N 65° E 26 "

from which I run S. 87° 15' E on true line


4200 Set Red Fir Post 4 x 4 inches 3 $\frac{3}{4}$ feet long with a handful of Charred Coal 18 inches in the ground from which a Pine 24 inch dia. brs S 73° 30' E 155 lks marked C.S.B.T. " 24 " " " N 30° E 227 " " C.S.B.T.

Var on E & West line at this point 15° 15' E

6125 Set Post for $\frac{1}{16}$ corner

8050 East boundary at $\frac{1}{4}$ Sec corner between Sec 23 & 24 from which a Pine 52 in brs S 38° E 90 lks " 40 " " N 66° W 165 "

The N $\frac{1}{2}$ Sec 23 through center N $\frac{1}{2}$ S is 3899 chains

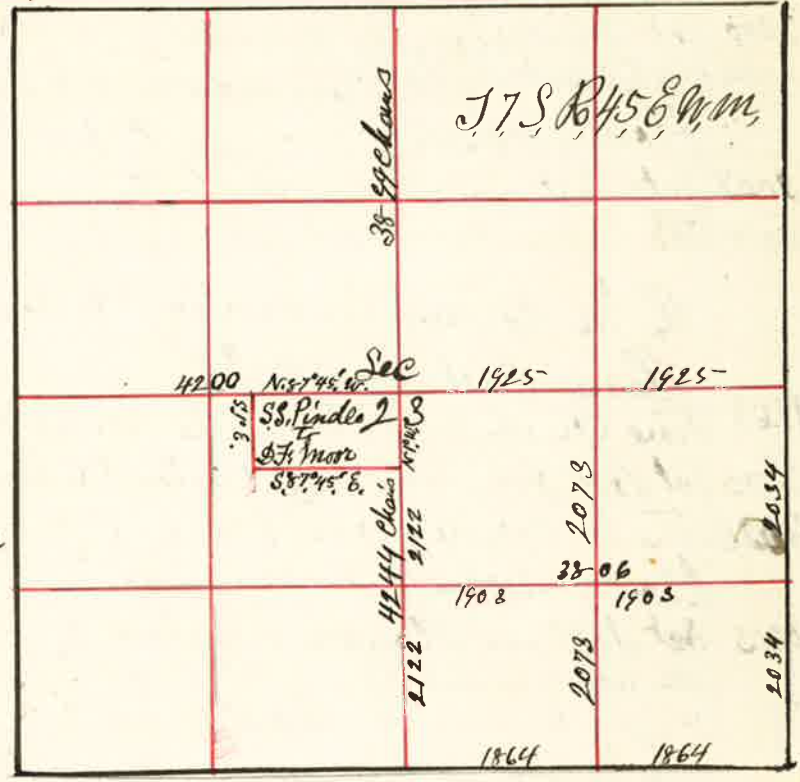

The Center Sec 23

Thence South var 19° E

2556 Pine creek 140 lks wide runs S. E.

4244 The $\frac{1}{4}$ Sec corner bet Sec 23 & 26 from which I run North

2122 Set Post for $\frac{1}{16}$ corner in center $\frac{1}{2}$ marked $\frac{1}{16}$ from which a Fir 4 inches brs S 88 $\frac{1}{2}$ ° E 44 lks dist

The $\frac{1}{4}$ Sec corner bet Sec. 23 & 24 Thence South var 20° E

2000 Set Post for temporary $\frac{1}{8}$ corner

4068 Intersect South boundary 39 lks East of corner to Sec 23-24-25 & 26 from which I run North on true line var 19° 45' E

2034 Set Post for $\frac{1}{8}$ corner from which a Pine 10 in brs N 21° E 32 lks

4068 The $\frac{1}{4}$ Sec cor bet Sec. 23 & 24

The corner to Sec 23-24-25- & 26 from which a Pine 20 in brs N 46° E 15 lks " 38 " " S 57° E 80 " " 8 " " S 87° W 68 " " 8 " " N 63° W 113 "

Thence West var 19° 45' E

1900 Set temporary $\frac{1}{8}$ corner Post

2331 Pine creek 100 lks wide runs South

3728 The $\frac{1}{4}$ Sec corner 60 lks South from which I run East

1864 Set Post for $\frac{1}{8}$ corner marked $\frac{1}{8}$ from which a Cottonwood 10 inches brs. S 21° 15' W 227 lks marked $\frac{1}{8}$ B.T. a Fir 14 in brs N 12° W 182 lks dist " $\frac{1}{8}$ B.T.

Thence North var 20° E

2078 Set Fir Post 4 inches square 2 $\frac{1}{2}$ feet long from which a Pine 12 in brs N 68° E 43 lks marked $\frac{1}{16}$ B.T. " 16 " brs S 68° W 40 " " $\frac{1}{16}$ B.T.

also a lot out of the N $\frac{1}{4}$ S $\frac{1}{4}$ Sec 23 described as follows to wit Beginning in the center Sec 23 Thence N 87° 45' W 62 Rods var 20° Thence South 1° E 30 Rods Thence S 87° 45' E 62 Rods a Post from which a Pine 14 in brs S 89° W 37 lks dist. Thence N 1° W 30 Rods to place of beginning containing 18 acres and 100 Rods nearly J.W. Kimbrell Co. Surveyor