



106 Surveyed for James Bright & John McDonald July 19 1889
By W. Kimbrell County Surveyor Plat No. 87

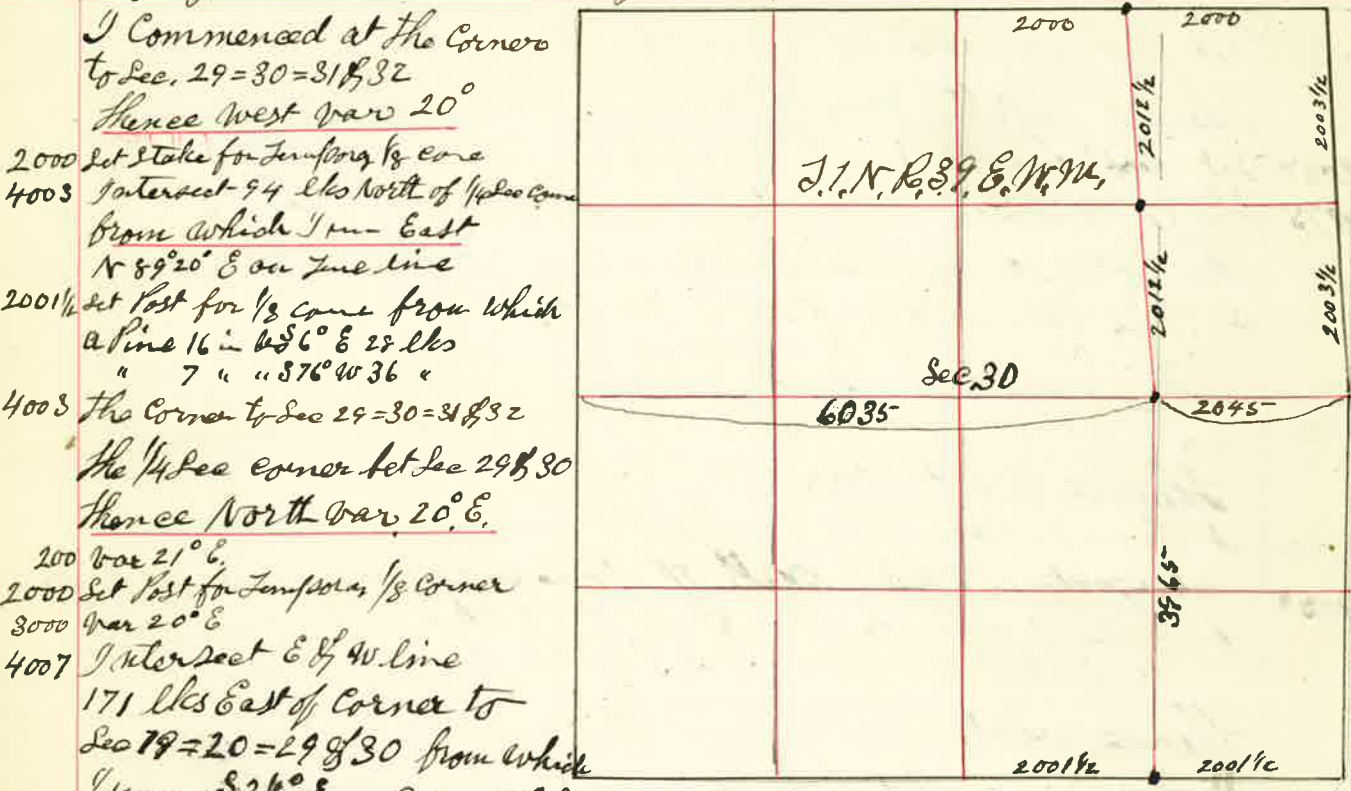

I Commenced at the Corner to Sec. 29=30=31&32
Hence west var 20°
2000 Set Stake for Temporary $\frac{1}{8}$ corner
4003 Intersect 94 lks North of $\frac{1}{4}$ Sec corner
from which I run East
 $N 89^\circ 20' E$ on true line
2001 1/2 Set Post for $\frac{1}{8}$ corner from which
a line 16 in $N 56^\circ E$ 29 lks
" 7 " " $S 76^\circ W$ 36 "
4003 The Corner to Sec 29=30=31&32
The $\frac{1}{4}$ Sec corner bet Sec 29&30
Hence North var $20^\circ E$.
200 var $21^\circ E$
2000 Set Post for Temporary $\frac{1}{8}$ corner
3070 var $20^\circ E$
4007 I Intersect E of W. line
171 lks East of Corner to
Sec 19=20=29&30 from which
I run $S 2 1/2^\circ E$ var $20^\circ E$
2003 1/2 Set Stone 4x12x22 inches marked $\frac{1}{8}$ for Center E side N E $\frac{1}{4}$ Sec 30
The Corner to Sec 19=20=29&30
Hence west var $21^\circ E$
2000 Set Temporary $\frac{1}{8}$ corner
4000 Intersect 24 lks North of $\frac{1}{4}$ Sec corner bet Sec 19 & 30
from which I run $N 89^\circ 30' E$ on true line var $21^\circ E$
2000 Set Post for $\frac{1}{8}$ corner on North Boundary N E $\frac{1}{4}$ Sec 30
4000 The Corner to Sec 19=20=29 & 30
The $\frac{1}{4}$ Sec corner on West Boundary Sec 30
Hence East through Center Sec 30 var $20^\circ E$.
6000 Set Stake for Temporary $\frac{1}{16}$ corner for Center E $\frac{1}{2}$ Sec 30
8080 Intersect East Boundary Sec 30 20 lks North of $\frac{1}{4}$ Sec Corner bet Sec 29 & 30
The $\frac{1}{8}$ corner on North side N E $\frac{1}{4}$ Sec 30 Hence South var $20^\circ E$
2000 Set Stake for Temporary $\frac{1}{16}$ corner in Center N E $\frac{1}{4}$
4025 Intersect E of W. line 10 lks west of 1st Stake at this point
8990 Intersect South Boundary at $\frac{1}{8}$ corner on South side S. E. $\frac{1}{4}$ Sec 3
from which I run North var $18^\circ 30' E$
3965 Set Stone 5x6x24 marked $\frac{1}{16}$ for Center E $\frac{1}{2}$ Sec 30 Hence North var $20^\circ 30' E$
5977 Set Stone 6x8x22 for Center N E $\frac{1}{4}$ Sec 30
W. Kimbrell County Surveyor

107 Surveyed for Houghton Perry & Co. Aug 7th 1889
By W. Kimbrell County Surveyor Plat No. 88.

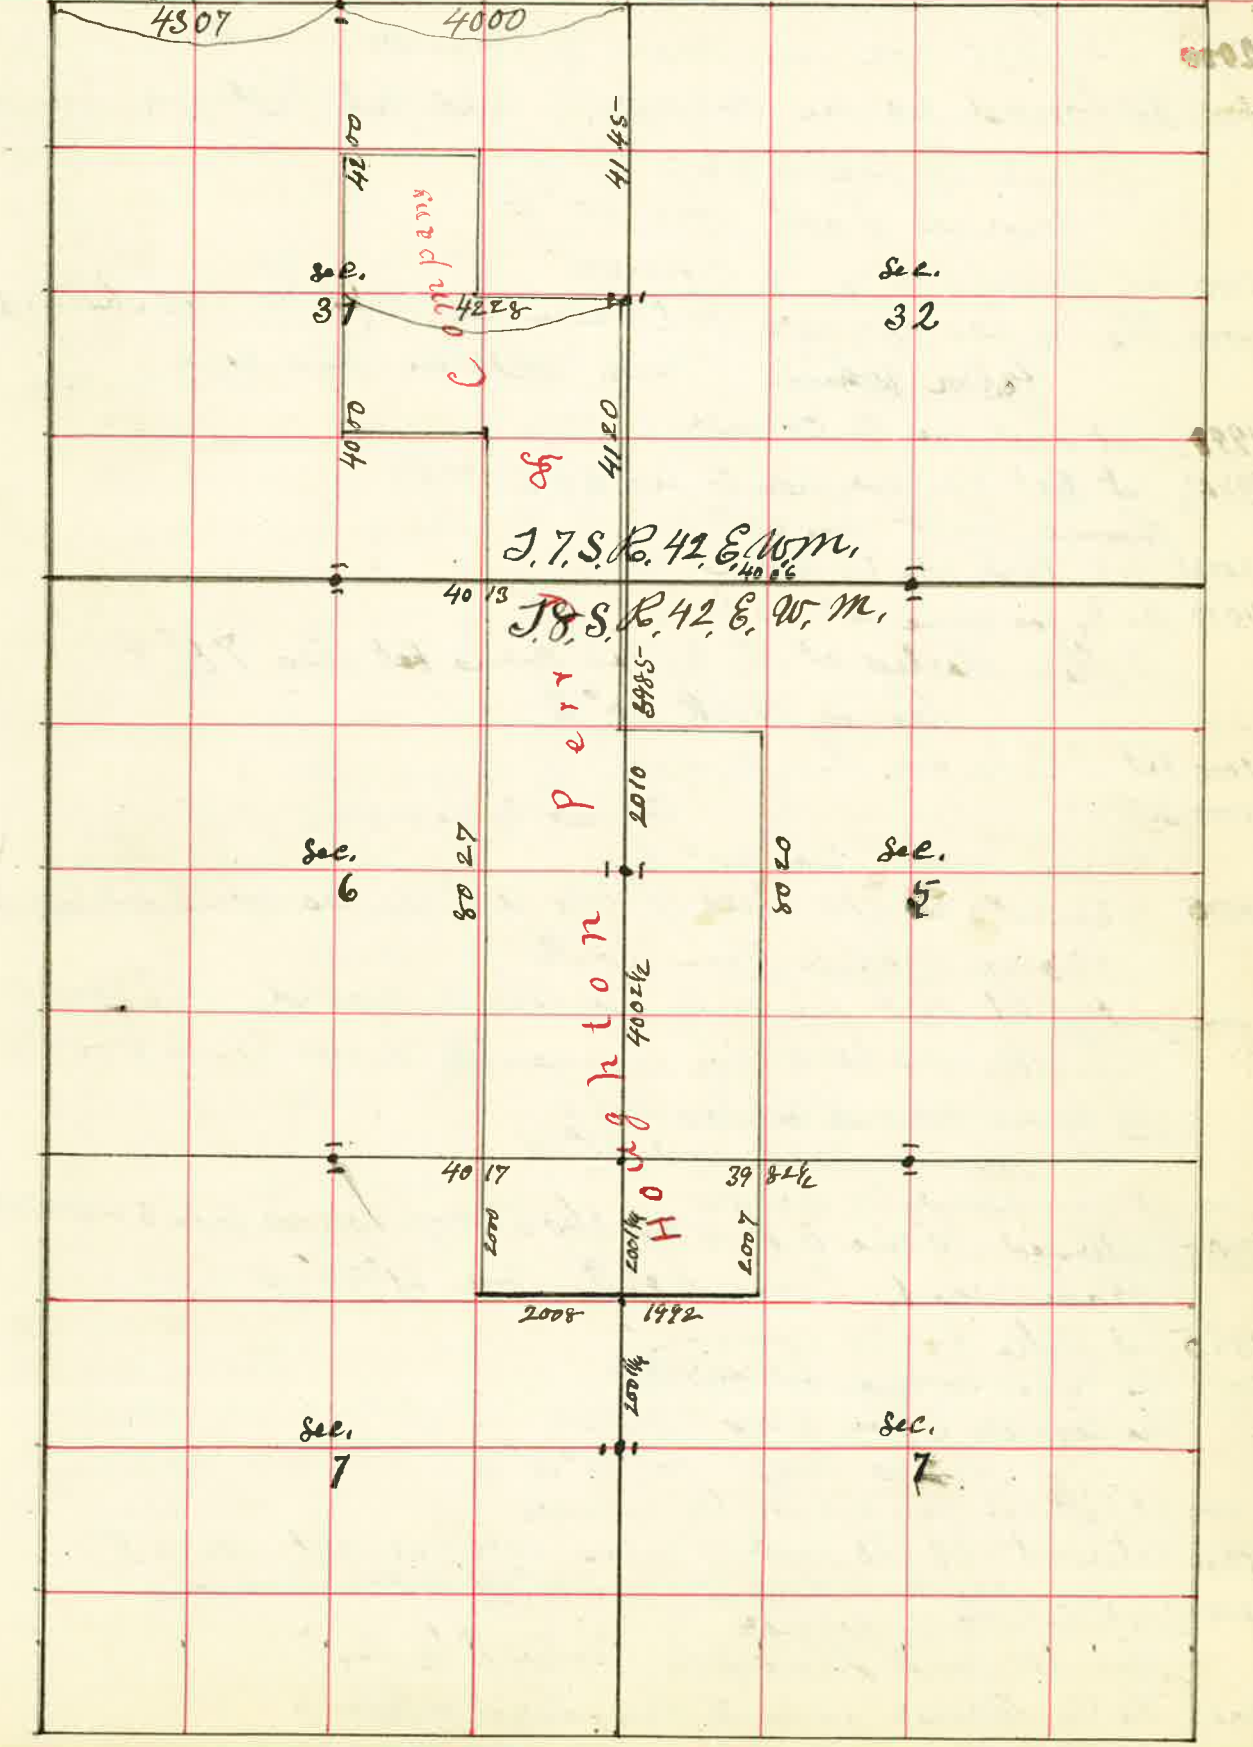

Houghton Perry
Sec. 32
Sec. 6
Sec. 5
Sec. 7
Sec. 7

Surveyed for Houghton Perry & Co. Aug. 7th 1889

I commenced at the $\frac{1}{4}$ Sec corner between Sec 6, 8, 7.

Thence East var $20^{\circ} E$

2000 Set Post for Temporary $\frac{1}{8}$ corner

4000 Set found no Sec corner, and set Post for Temporary

Corner to Sec 5=6=7 & 8

Thence East var $20^{\circ} E$

2000 Set Temporary $\frac{1}{8}$ corners

4000 The $\frac{1}{4}$ Sec corners between Sec 5 & 8, 40 lks North of
from which I run West on true line

1990 $\frac{1}{2}$ Set Post for $\frac{1}{8}$ corner

3982 $\frac{1}{2}$ Set Post for corner to Sec 5=6=7 & 8

Thence West var $20^{\circ} E$

2008 $\frac{1}{2}$ Set Post for $\frac{1}{8}$ corner

4017 the $\frac{1}{4}$ Sec corner bet Sec 6 & 7

I then started at the $\frac{1}{4}$ Sec corner bet Sec 7 & 8

Thence North $20^{\circ} E$

2000 set Stake for Temporary $\frac{1}{8}$ corners

4000 Set " " " Corner to Sec 5=6=7 & 8

Thence North var $20^{\circ} E$

4000 $\frac{1}{2}$ Intersect 28 lks West of old U.S. $\frac{1}{4}$ Sec corner bet Sec 5 & 6
from which I run South

4002 $\frac{1}{2}$ Set Old Post firmly in the ground in Houghtons
Timothy Meadow for permanent corner to Sec 5=6=7 & 8

The $\frac{1}{4}$ Sec corner bet Sec 5 & 6

Thence North var $21^{\circ} E$

2000 Set Temporary $\frac{1}{8}$ corners

3995 Intersect Ho line 8 $\frac{1}{2}$ of 2587 lks East of corner to Sec 5=6=81 & 32

from which I run South var $21^{\circ} 45' E$

1985 Set Stake for $\frac{1}{8}$ corner

3895 the $\frac{1}{4}$ Sec corner bet Sec 5 & 6

The corner to Sec 5=6=81 & 32

Thence West var $19^{\circ} 15' E$

2000 Set Post for Temporary $\frac{1}{8}$ corner

4013 Intersect 40 lks South of $\frac{1}{4}$ Sec corner bet Sec 6 & 7

from which I run $S 89^{\circ} 45' E$ on true line

2006 $\frac{1}{2}$ Set Stake for $\frac{1}{8}$ corner

Thence South through Center $\frac{1}{2}$ Sec 7

8027 the $\frac{1}{8}$ corner on South Boundary S W $\frac{1}{4}$ Sec 6

Surveyed for Houghton Perry & Co. Aug 7 1889

The $\frac{1}{8}$ corner on North Boundary $N 20^{\circ} E \frac{1}{4}$ Sec 7

Thence South var $20^{\circ} E$

2000 Set Post for $\frac{1}{16}$ corner in Center N, E $\frac{1}{4}$ Sec 7

Thence East var $20^{\circ} E$

2008 The $\frac{1}{8}$ corner Thence East

1992 Set Post for $\frac{1}{16}$ corner in Center N, W $\frac{1}{4}$ Sec 8

Thence North var $20^{\circ} E$

2007 The $\frac{1}{8}$ corner

The corner to Sec 5=6=81 & 82

Thence East var $19^{\circ} 15' E$

2000 Set Temporary Stake for $\frac{1}{8}$ corner

4006 Intersect 28 lks South of $\frac{1}{4}$ Sec corner bet Sec 5 & 8

from which I run West on true line

2008 Set Post for $\frac{1}{8}$ corner

Thence South var $20^{\circ} E$

8020 South Boundary Sec 5 at the $\frac{1}{8}$ corner on South Boundary S W $\frac{1}{4}$ Sec 5

The corner to Sec 5=6=81 & 82

Thence North var $20^{\circ} E$

4120 Intersect 497 lks West of $\frac{1}{4}$ Sec corner bet Sec 81 & 82

The $\frac{1}{4}$ Sec corner between Sec 6 & 81

Thence North var $20^{\circ} E$

2000 Set Post for Temporary $\frac{1}{16}$ corner in center S $\frac{1}{2}$ Sec 31

4000 Set " " " " " " in Center Sec 31

8200 Intersect North Boundary Sec 31 485 lks West of $\frac{1}{4}$ Sec bet Sec 30 & 31

I therefore re-chained the line bet Sec 30 & 31 starting at the

Range line bet Ranges 41 & 42 at corner to Sec 30=31=25 & 86

Thence East var $20^{\circ} E$

4307 The $\frac{1}{4}$ Sec corner bet Sec 30 & 31

8307 the corner to Sec 29=30=31 & 32

Thence South var $20^{\circ} E$

4145 Intersect 282 lks West of $\frac{1}{4}$ Sec corner bet Sec 31 & 32

Thence West var $20^{\circ} E$

4228 The center Sec 31

J. W. Kimbell
County Surveyor