RECORD OF SURVEY No. 233

by request of Inland Irrigation Co. by W. J. Farnish Dec 19 1905

5/955 GLASS & PROHOMME COMPANY, PRINTERS AND BOOKBINDERS, PORTLAND

Chains Links

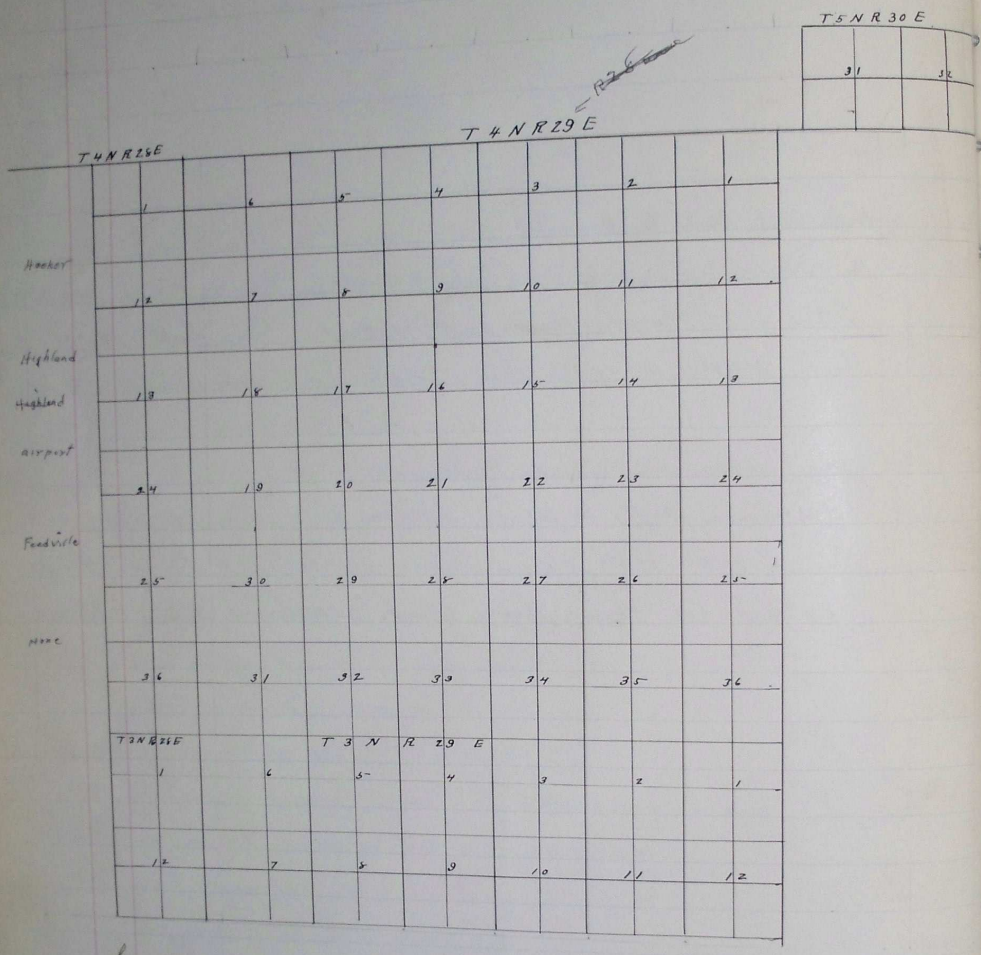

Survey commenced Dec. 19th 1905

Witt L M Scott and Theodore Carroll as chainman

and Walter Bremore as Flagman

and Joe Allen axman and marker

I commenced at the 1/4 Sec cor bet Secs 9 & 16

thence I run North on random line through centre of Sec 9

40.00 set temporary centre corner

50.00 a point - 132 lks west of 1/4 Sec cor point - bet Secs 4 & 9

East through centre Sec 9

87.00 a point 54 lks south of 1/4 Sec point bet Secs 9 & 10

thence west on true line 39.50 set port for centre of Sec 9

Chains	Links	
		on a right line at Intersect of Tune E & W and N & S line from 1/4 Sec
		to 1/4 Sec corner and deposited Stone Coal N & South of post 5 ft dist from post
		Commencing at the cor to secs 4-5-8 & 9
		I run East bet Secs 4 & 9
79	24	a point 18 lks South of cor to secs 3-4-9 & 10
		thence West on Tune line
39	62	Set cedar post marked 1/4 S 9 on S & S 4 on N face and deposite Stone Coal
		under post over E & W 5 ft dist from post 18 ins in ground
		North bet Secs 3 & 4
80	60	the cor to secs 3-4-33 & 34
		thence South on Tune line bet Sts 3 & 4
40	43	Set cedar post with Stone Coal deposite underneath and deposite Stone Coal
		18 ins deep N & South of post 5 ft dist
		West bet Secs 4 & 33
79	32	the cor to secs 4-5-32 & 33
		thence East on Tune line bet Secs 4 & 33
39	66	Set cedar post marked 1/4 S and deposite Stone Coal 18 inch deep E & W
		5 ft dist from post
		West bet Secs 5 & 8
20	31	Set Cedar post for 1/16 cor and Stone Coal
25	38	set Stone 16 x 8 x 3 ins for Fractional cor 20 lks west of Centre of O R R & N R R.
		Track on East side of Umatilla river
		South bet Secs 4 & 5
80	20	the cor to Secs 4-5-8 & 9
		thence North on Tune line bet Secs 4 & 5
40	00	Set Iron pin in Stone for 1/4 Sec cor deposite Stone Coal N & S 18 inch deep
		5 ft dist from post

RECORD OF SURVEY No.

5103 GLASS & PROUHOMME COMPANY, PRINTERS AND BOOKBINDERS, PORTLAND

Chains	Links	
		West through center Sec 5
20	00	set temporary 1/16 cor
25	00	" " " Fractional cor
54	71	Umatilla river pass North 25 lks across
80	20	the 1/4 Sec cor bet Secs 5 & 6
		thence East on True line
55	10	set 1 iron Rod for Fractional cor deposit stone coal S & W 5 ft dist
60	15	" " " " 1/16 cor and deposite stone coal S & W " "
		East through center Sec 4
80	00	the 1/4 Sec cor bet Secs 3 & 4
		thence West on True line and at
40	00	set cedar post for center Sec 4 on True S & W and N & S line from 1/4 Sec to 1/4 Sec cor and deposite stone coal N & S of post 5 ft dist from post
		Dec 21st 1905
		West bet Secs 2 & 35
80	80	a point 68 lks South of cor to Secs 2-3-34 & 35
		thence East on True line
40	40	set cedar post for 1/4 Sec cor and deposite stone coal S & W 5 ft dist
		West bet Secs 4 & 33
79	32	the cor to Secs 4-5--32 & 33
		thence East on True line
39	66	set cedar post for 1/4 Sec cor bet Secs 4 & 33 deposite stone coal S & W 5 ft dist
		East bet Secs 28 & 33
78	25	the cor to Secs 27-28-33 & 34
		thence West on True line
39	12½	set cedar post for 1/4 Sec cor bet Secs 28 & 33 deposite stone coal S & W 5 ft dist
		East bet Secs 27 & 34
		set temporary at 40 & 80 chs

RECORD OF SURVEY No.

Chains	Links	
16	00	the cor to secs 25-26-35 & 36
		thence west on true line
40	00	set cedar post for 1/4 sec cor bet secs 26 & 35 - deposit stone coal
80	00	" " " for cor to secs 26-27-34 & 35 deposit stone coal 18 inches under post and N & S & SW & NW 5 ft dist
		thence west bet secs 27 & 34
40	00	set cedar post with stone coal deposits E & W 5 ft dist
		North bet secs 34 & 35
80	00	the cor to secs 26-27-34 & 35
		thence south on true line
40	00	set cedar post with stone coal deposits N & S 5 ft dist
		North bet secs 33 & 34
80	06	the cor to secs 27-28-33 & 34
		thence south on true line
40	03	set cedar post for 1/4 sec cor with deposit of stone coal N & S 5 ft dist
		I then set cedar post for center of secs 33 & 34 with deposit of stone coal N & S 5 ft dist from posts on true line N S - E & W from the 1/4 secs corners by alignement from 1/4 sec to 1/4 sec corners
		Commencing at the cor to secs 25-26-35 & 36
		thence north bet secs 25 & 36
40	00	set temporary 1/4 sec cor
80	00	" " cor for secs 23-24-25 & 26
		thence north bet secs 23 & 24
40	00	set temporary 1/4 sec cor
80	00	" " cor for secs 13-14-23 & 24
		thence north bet secs 13 & 14
40	00	set temporary 1/4 sec cor
80	00	" " cor to secs 11-12-13 & 14


Chains	Links	
		thence North bet Secs 11 & 12
40	00	set Temporary 1/4 Sec cor
80	00	set " Cor to Secs 1-2-11 & 12
		thence North bet Secs 1 & 2
40	00	set Temporary 1/4 Sec cor
79	37	a point - on Standard line 372 lks East of CC to Secs 1 & 2
		my correction would therefore be to move such Temporary stake 37 lks West
		and my course would be S 0 30' E on True line
39	48	set cedar post for 1/4 Sec cor bet Secs 1 & 2 deposite stone Coal N & S 5 ft dist
79	46	set cedar post for Cor to Secs 1-2-11 & 12 deposite stone Coal N 6-S 6-E & W
		from corner 5 ft dist
		thence S 0 30' E on True line bet Secs 11 & 12
39	99	set cedar post for 1/4 Sec cor bet Secs 11 & 12 deposite stone Coal N & S 5 ft dist
79	98	set cedar post for Cor to Secs 11-12-13 & 14 and deposite stone Coal N 6-S
		E W and N W from post 5 ft dist
		thence S 0 30' E on True line bet Secs 13 & 14
39	99	set cedar post for 1/4 Sec cor and deposite stone Coal N & S 5 ft dist
79	98	set cedar post for Cor to Secs 13-14-23 & 24 and deposite stone Coal
		N 6 - S 6 - E W and N W from post 5 ft dist
		thence S 0 30' E on True line bet Secs 23 & 24
39	99	set cedar post for 1/4 Sec cor bet Secs 23 & 24 deposite stone Coal N & S 5 ft dist
79	98	set cedar post for cor to Secs 23-24-25 & 26 and deposite stone Coal
		N 6 - S 6 - E W and N W from post cor 5 ft dist
		thence S 0 30' E on True line bet Secs 25 & 26
39	99	set cedar post for 1/4 Sec cor and deposite stone Coal N & S 5 ft dist
79	98	the cor to Secs 25-26-35 & 36
		from the cor to Tps 3 & 4 N R 6 E 29 & 30 6 mm
		North bet Secs 31 & 36
80	00	stone corner to Secs 25-30-31 & 36
		thence North bet Secs 25 & 30
80	00	the cor to Secs 19-30-24 & 25

RECORD OF SURVEY No.

Chains	Links	
		thence North bet Secs 19 & 24
80	45	the Cor to Secs 18-19-13 & 24
		thence North bet Secs 13 & 18
80	00	the Cor to Secs 12-13-7 & 18 a stone
		North bet Secs 26 & 27
40	00	set Temporary 1/4 Sec Cor
80	00	set " Cor for Secs 22-23-26 & 27
		thence North bet Secs 22 & 23
40	00	set Temporary 1/4 Sec Cor
73	15	dist to SW & NE
80	00	set Temporary Cor for Secs 14-15-22 & 23
		thence North bet Secs 14 & 15 -
40	00	set Temporary 1/4 Sec Cor
80	00	set " Cor for Secs 10-11-14 & 15 -
		thence North bet Secs 10 & 11
40	00	set Temporary 1/4 Sec Cor
80	00	set Temporary Cor for Secs 2-3-10 & 11
		thence at right angles to line and run East bet Secs 2 & 11
40	00	set Temporary 1/4 Sec Cor
79	90	the Cor to Secs 1-2-11 & 12
		thence west on True line bet Secs 2 & 11
39	95	set Cedar post for 1/4 Sec Cor deposite stone Cairn 3 ft W 5 ft dist
79	90	the Cor to Secs 2-3-10 & 11
		thence South on True line bet Secs 10 & 11
40	00	set Cedar post for 1/4 Sec Cor and deposite stone Cairn N & 05 ft dist
80	00	set Cedar post for Cor to Secs 10-11-14 & 15 and deposite stone Cairn N 6-06 SW & NW from post 5 ft dist
		thence South on True line bet Secs 14 & 15 -
40	00	set Cedar post for 1/4 Sec Cor deposite stone Cairn N & 0 5 ft dist
80	00	set Cedar post for Cor to Secs 14-15-22 & 23 and deposite stone Cairn N 6-06 - SW & NW from post 5 ft dist -

RECORD OF SURVEY No.

Chains	Links	
		thence South on Tme line bet Secs 22 & 23
40	00	set Cedar post for 1/4 Sec cor deposits Stone Cairn N & S 5 ft dist
80	00	the cor to Secs 22-23-26 & 27
		thence East on random line bet Secs 23 & 26
40	00	set Temporary 1/4 Sec cor
80	05	the cor to Secs 23-24-26 & 25
		thence West on Tme line bet Secs 23 & 26
40	05½	set Cedar post for 1/4 Sec cor deposits Stone Cairn E & W 5 ft dist
80	05	the cor to Secs 22-23-26 & 27
		East on random line bet Secs 14 & 23
40	00	set Temporary 1/4 Sec cor
79	84	a point 13 lks South of cor to Secs 13-14-23 & 24
		thence S 89° 45' W on Tme line bet Secs 14 & 23
39	92	set Cedar post for 1/4 Sec cor deposits Stone Cairn E & W 5 ft dist
79	84	the cor to Secs 14-15-22 & 23
		East on random line bet Secs 11 & 14
40	00	set Temporary 1/4 Sec cor
79	69	a point 68 lks South of cor to Sec 11-12-13 & 14
		thence S 89° 31' W on Tme line bet Secs 11 & 14
39	85	set Cedar post for 1/4 Sec cor deposits Stone Cairn E & W 5 ft dist
79	69	the cor to Secs 10-11-14 & 15
		East on random line bet Secs 12 & 13
40	00	set Temporary 1/4 Sec cor
79	91	a point 50 lks North of cor to Secs 12-13-7 & 18
		thence N 89° 25' W on Tme line bet Secs 12 & 13
39	95½	set Cedar post for 1/4 Sec cor deposits Stone Cairn E & W 5 ft dist
		West on Tme line bet Secs 1 & 12
39	90	set Cedar post for 1/4 Sec cor deposits Stone Cairn E & W 5 ft dist
79	80	the cor to Secs 1-2-11 & 12

RECORD OF SURVEY No.

Chains	Links	
		From the cor to secs 10-11-14 & 15 I mon
		West on Blank line bet secs 10 & 15
40	00	set temporary 1/4 sec cor
80	00	" " cor to secs 9-10-15 & 16
		thence west bet secs 9 & 16
40	00	set temporary 1/4 sec cor
80	00	" " cor to secs 8-9-16 & 17
		thence west bet secs 8 & 17
40	00	set temporary 1/4 sec cor
80	00	" " cor for secs 7-8-17 & 18
		thence west bet secs 7 & 18
40	00	set temporary 1/4 sec cor
87	74	a point 325 lks North of the cor to secs 7-18-12 & 13
		My correction would be therefore 50 lks South to each mile and true course
		N 89° 26' W on true line bet secs 7 & 18
47	74	set cedar post for 1/4 sec cor deposits stone coal B & W 5 ft deep
87	74	set cedar post for cor to secs 7-8-17 & 18 deposits stone coal NB-SB-SW & NW 5 ft deep
		thence N 89° 26' W on true line bet secs 8 & 17
40	00	set cedar post for 1/4 sec cor deposits stone coal B & W 5 ft deep
80	00	" " " for cor to secs 8-9-16 & 17 deposits stone coal NB-SB-SW & NW 5 ft deep
		thence N 89° 26' W on true line bet secs 9 & 16
40	00	set cedar post for 1/4 sec cor deposits stone coal B & W 5 ft deep
80	00	" " " for cor to secs 9-10-15 & 16 deposits stone coal NB-SB-SW & NW 5 ft deep
		thence N 89° 26' W on true line bet secs 10 & 15
40	00	set cedar post for 1/4 sec cor deposits stone coal B & W 5 ft deep
80	00	the cor to secs 10-11-14 & 15
		Commencing at the cor to secs 2-3-10 & 11 I mon
		West on Blank line bet secs 3 & 10
77	68	a point 75 lks North of the post cor to secs 3-4-9 & 10
		thence N 89° 26' W on true line bet secs 3 & 10
39	84	set cedar post for 1/4 sec cor deposits stone coal B & W 5 ft deep
79	66	true cor to secs 2-3-10 & 11

RECORD OF SURVEY No. _____

GOSS, GLASS & PRUDHOMME COMPANY, PRINTERS AND BOOKBINDERS, PORTLAND

Chains	Links	
		North bet Secs 9 & 10
40	08	Set cedar post for 1/4 Sec cor deposits Stone Coal N & D 5 ft dist
80	16	The sta cor to Secs 3-4-9 & 10 set New cedar post deposits Stone coal N6-D6-DW & NW 5 ft
		West on Blank line bet Secs 4 & 9
40	00	Set Temp Sec 1/4 Sec cor
79	00	" " cor for Secs 4-5-8 & 9 as per original U.S. Notes
		Extended line West bet Secs 5 & 8
40	00	Set Temp Sec 1/4 Sec cor
80	00	" " cor to Secs 5-6-7 & 8
		Thence Extended line West bet Secs 6 & 7
40	00	Set Temp Sec 1/4 Sec cor
88	18	a point 2 lks No North of the cor to Secs 6-7-1 & 12
		My correction would therefore be 82 lks South and 28 lks W to each mile
		and my True course would be N89°25' E
		N89°25' E on True line bet Secs 6 & 7
48	06	Set cedar post for 1/4 Sec cor deposits Stone coal S & W 5 ft dist
88	12	Set cedar post for cor to Secs 5-6-7 & 8 deposits Stone coal N6-S6-DW & NW 5 ft
		Thence N89°25' E on True line bet Secs 5 & 8
40	06	Set cedar post for 1/4 Sec cor deposits Stone coal S & W 5 ft dist
80	02	Set cedar post for cor to Secs 4-5-8 & 9 deposits Stone coal N6-D6-DW & NW 5 ft dist
		Thence N89°25' E on True line bet Secs 4 & 9
39	51	Set cedar post for 1/4 Sec cor deposits Stone coal S & W 5 ft dist
79	02	The cor to Secs 3-4-9 & 10
		North bet Secs 8 & 9
40	04	Set cedar post for 1/4 Sec cor deposits Stone Coal N & D 5 ft dist
80	08	The cor to Secs 4-5-8 & 9
		North bet Secs 7 & 8
40	00	Set cedar post for 1/4 Sec cor deposits Stone Coal N & D 5 ft dist
80	00	The cor to Secs 5-6-7 & 8

RECORD OF SURVEY No.

Chains	Links	
		North bet Secs 3 & 4
40	00	Set temporary 1/4 Sec cor
81	73	a point 65 lks East of CC to Secs 3 & 4
		thence So 21' E on true line bet Sts 3 & 4
41	38	Set cedar post for 1/4 Sec cor deposits stone cairn N & S 5 ft dist
81	73	the cor to Secs 3-4-9 & 10
		West along North Boundary Sec 4-5 & 6 and Sec's temporary Corners at 40 & 80 ch and find the distance to be 16 lks in excess of original U.S. field Notes
		thence
		East on true line on North Boundary of Sec 6
47	27 27	Set cedar post for 1/4 Sec cor Marked CC 1/4 S 6 on S face deposits stone cairn E & W 5 ft dist
87	30	Set cedar post for CC to Secs 5 & 6 marked CC T 4 N R 5 & R 6 deposits stone cairn E & W 5 ft dist
		thence East on true line on N Bdy Sec 5
40	02½	Set cedar post for CC 1/4 Sec to Sec 5 deposits stone cairn E & W 5 ft dist
80	05	Set cedar post for CC to Secs 4 & 5 deposits stone cairn E & W 5 ft dist
		thence East on true line on N Bdy Sec 4
40	02½	Set cedar post for CC 1/4 Sec to Sec 4 deposits stone cairn E & W 5 ft dist
80	05	the CC to Secs 3 & 4 T 4 N R 29 E
		North bet Secs 4 & 5
40	00	Set temporary 1/4 Sec cor
81	70	the CC to Secs 4 & 5
		thence South on true line bet Secs 4 & 5
41	70	Set cedar post for 1/4 Sec cor deposits stone cairn N & S 5 ft dist
81	70	the cor to Secs 4-5-8 & 9
		North bet Secs 5 & 6
40	00	Set temporary 1/4 Sec cor
82	50	the CC to Secs 5 & 6
		thence South on true line bet Secs 5 & 6
42	52	Set cedar post for 1/4 Sec cor deposits stone cairn N & S 5 ft dist
82	50	CC to Secs 5-6-7 & 8

Chains	Links	
		North bet Secs 32 & 33
40	00	Stone for 1/4 Sec cor
80	00	The Stone cor to Secs 28-29-32 & 33
		thence East on random line bet Secs 28 & 33
40	00	set temporary 1/4 Sec cor
78	25	a point 17 lks South of Cor to Secs 27-28-33 & 34
		thence S 89°45' W on true line bet Secs 28 & 33
39	12	set cedar post for 1/4 Sec cor deposite stone cairn 6 & W 5 ft dist
78	25	The cor to Secs 28-29-32 & 33
		thence north bet Secs 28 & 29
39	88	old cor for 1/4 Sec cor set cedar post deposite stone cairn
79	74	the old cor to Secs 20-21-28 & 29 set cedar post in place and deposite stone cairn NB-SB-SW & NW 5 ft dist
		East on random line bet Sec 27 & 34
40	00	set temporary 1/4 Sec cor
80	20	The cor to Secs 26-27-34 & 35
		thence west on true line bet Secs 27 & 34
40	10	set cedar post for 1/4 Sec cor deposite stone cairn E & W 5 ft dist
80	20	The cor to Secs 27-28-33 & 34
		thence north bet Sec 27 & 28
40	06	the old 1/4 Sec cor set cedar post for 1/4 Sec cor deposite stone cairn NB SB SW
80	23	the old cor to Sec 21-22-27 & 28 set cedar post deposite stone cairn NB-SB-SW & NW 5 ft dist
		thence East on random line bet Secs 22 & 27
40	34	old 1/4 Sec cor set cedar post deposite stone cairn S & W 5 ft dist
80	79	the cor to Secs 26-23-26 & 27 Sec 27 1906
		East on random line bet Sec 21 & 28
40	00	set temporary 1/4 Sec cor
79	11	The cor to Secs 21-22-27 & 28

Chains	Links	
		Thence West on same line bet Ss 21 & 28
39	05	Set cedar post & stone for 1/4 Sec cor deposits Stone Coal B & W 5 ft dist
		North bet Secs 21 and 22
40	00	Set temporary 1/4 Sec cor
80	00	Set temporary cor for Secs 15-16-21 & 22
		Thence extend my line
		North bet Secs 15 & 16
40	00	Set temporary 1/4 Sec cor
79	86	The cor to Secs 9-10-15 & 16
		Thence South on same line
39	99	Set cedar post for 1/4 Sec cor deposits Stone Coal N & S 5 ft dist
79	98	Set cedar post for cor to Secs 15-16-21 & 22 deposits Stone Coal N & S - SW & NW from post 5 ft dist
		Thence South on same line bet Secs 21 & 22
39	99	Set cedar post for 1/4 Sec cor deposits Stone Coal N & S 5 ft dist
79	98	The cor to Secs 21-22-27 & 28
		East on random line bet Ss 15 & 22
40	00	Set temporary 1/4 Sec cor
80	04	The cor to Secs 14-15-22 & 23
		Thence West on same line bet Secs 15 & 22
40	02	Set cedar post for 1/4 Sec cor deposits Stone Coal B & W 5 ft dist
80	04	The cor to Secs 15-16-21 & 22
R 28/R 29		[illegible]
		From the established corner on Range line bet Ranges 28 & 29 to Secs 12-13-7 & 18 I run South and at
40	00	Set temporary 1/4 Sec cor
80	00	" " cor to Secs 18-19-13 & 24
		I extend my line South
40	00	Set temporary 1/4 Sec cor
80	00	" " cor to Secs 19-30-24 & 25

RECORD OF SURVEY No.

Chains	Links	
		Thence South bet Secs 30 & 25
40	00	set temporary 1/4 Sec cor
79	24	a point at cor to Secs 30-31-25 & 36
		thence North on Tine line bet Secs 25 & 30
39	88	set cedar post for 1/4 Sec cor deposite stone cairn N & S 5 ft dist
79	76	set cedar post for cor to Secs 19-30-24 & 25 deposite stone cairn NG-DG-SW & NW from post 5 ft dist
		thence North on Tine line bet Secs 19 & 24
39	88	set cedar post for 1/4 Sec cor deposite stone cairn N & S 5 ft dist
79	76	set cedar post for cor to Secs 18-19-13 & 24 deposite stone cairn NG-DG-SW & NW from post 5 ft dist
		thence North on Tine line bet Secs 13 & 18
39	88	set cedar post for 1/4 Sec cor deposite stone cairn N & S 5 ft dist
79	76	the cor to Secs 12-13-7 & 18
		West on random line bet Secs 18 & 19
40	00	set temporary 1/4 Sec cor
88	10	a point 48 lks S of the cor to 18-19-13 & 24
		thence I run S 89° 38' 0" on Tine line bet Secs 18 & 19
48	10	set cedar post for 1/4 Sec cor deposite stone cairn S & W 5 ft dist
88	10	the old cor to Secs 17-18-19 & 20 I set cedar post and deposite stone cairn NG-DG-SW & NW from post 5 ft dist
		thence North on Tine line bet Secs 17 & 18
40	00	set cedar post for 1/4 Sec cor deposite stone cairn N & S 5 ft dist
80	00	the cor to Secs 7-8-17 & 18
Note		I set cedar post and deposited stone cairn N & S of for. Center of ann on the intersection of Tine N & S-G & W lines from the 1/4 Sec corners by allignment as required in Secs 4-5-6-7-8-9-10-11-12 13-14-15-18-21-22-23-26-27-28-33-34 T 4 N R 6 W 6 also Secs 13 & 24 in T 4 N R 6 W 6

RECORD OF SURVEY No.

Chains	Links	
		T 4 N R 28 E
		West bet Secs 13 & 24
40	00	set Surveyors 1/4 Sec cor
80	58	a point 14 lks South of the cor to Secs 13-14-23 & 24
		thence S 89° 48' E on True line bet Secs 13 & 24
40	29	set cedar Post for 1/4 Sec cor deposits Stone Cond & SW 5 ft dist
80	58	the cor to Secs 13-24-18 & 19
		South on True line bet Secs 23 & 24
40	00	set cedar post for 1/4 Sec cor deposits Stone Cond N & S 5 ft dist
80	00	set cedar post for cor to Secs 23-24-25 & 26 and deposits Stone Cond
		N 6 - D G - SW & N W from post 5 ft dist
		thence East on random line bet Secs 24 & 25
40	00	set Surveyors 1/4 Sec cor
81	00	the cor to Secs 19-30-24 & 25
		thence West on True line bet Secs 24 & 25
40	50	set cedar post for 1/4 Sec cor deposits Stone Cond E & W 5 ft dist
81	00	the cor to Secs 23-24-25 & 26
		T 5 N R 30 E
		From the CC to T 4 N R 29 & 30 E 1 mile East on Standard line
77	70	the old Standard cor to T 5 N R 29 & 30 E set cedar post deposits Stone Cond
		thence East on South boundary Sec 31 T 5 N R 30 E
80	00	the old Standard cor to Secs 31 & 32
		thence North bet Secs 31 & 32 set Surveyors Corners at 20-40 & 60 chs and at 80 chs the corr cor
		thence South on True line bet Secs 31 & 32
20	00	set cedar post for 1/16 cor deposits Stone Cond N & S 5 ft dist - thence East through Centre 1/4 Sec 32
40	00	set cedar post for Centre 1/4 Sec 32 deposits Stone Cond N & S of post 5 ft dist
		South on former line bet Secs 31 & 32
30	50	Cold Spring Canyon course West
40	00	set cedar post for 1/4 Sec cor deposits Stone Cond N & S 5 ft dist
60	00	set cedar post for 1/16 cor deposits Stone Cond N & S 5 ft dist
		thence East through Centre 1/2 Sec 32
40	00	set cedar post for Centre 1/4 Sec 32 deposits Stone Cond N & S 5 ft dist
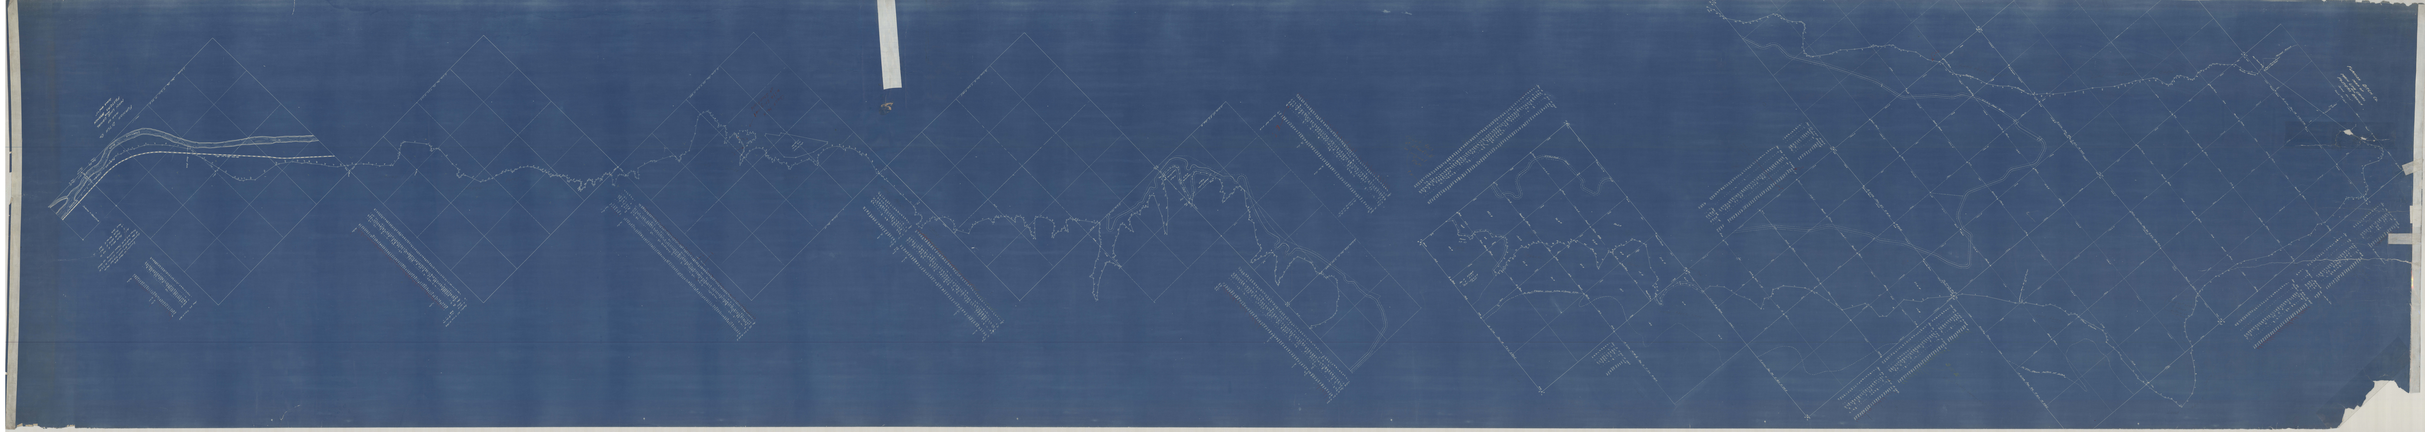
John W. Kindell County Surveyor