

RECORD OF SURVEY No. 235-

Request of Ed LaFare Feb 8th 1906

13 N 16356 W M

Chains Links

East lot per 17 920

60 47 The 1/4 sec ea lot per 16 821

North through center 1/2 sec 21

40 71 The 1/4 ea in center per 21

North lot per 20 821

40 42 The 1/4 sec ea lot per 20 821

East through center 1/2 of SW 1/4 sec 21


East through center N 1/2 of N 1/2 of SW 1/4 of sec 21

4000 The fractional corner in center of N 1/2 of SW 1/4 sec 21

John W. White county Surveyor

T. 3, N. R. 35, E

Center

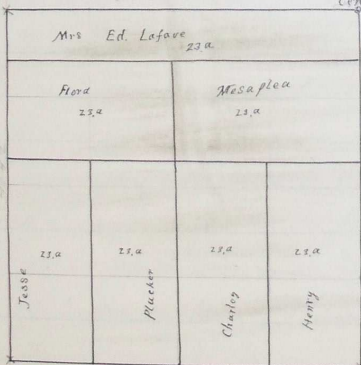

S