RECORD OF SURVEY No. 326

By Request of Park - Phelps - Embry - McCary - Tucker - Shell - Geary - Cot Kin - Carter.

Chains Links

T5N R28E WM aug. 24th 1910

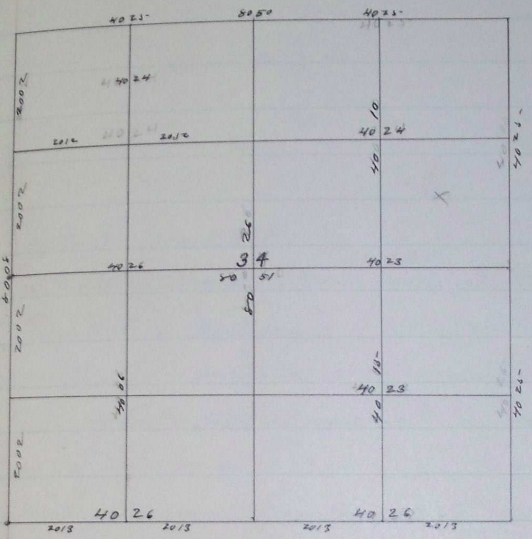

North bet secs 34 and 35

20 00 Set Temporary 1/16 cor

40 00 " " " 1/16 cor

60 00 " " " 1/16 cor

80 50 The cor to secs 26-27-34 and 35

West through center sec 34

80 51 The 1/4 sec corner bet secs 33 & 34

North through center sec 34 and at 20-40-60. chs

80 26 The 1/4 sec corner bet secs 27 & 34

West along South Boundary of sec 34

40 26 The 1/4 sec corner

80 58 the standard corner of secs 33 & 34

East bet secs 27 & 34 and at 20-40-60 chs set temp cor

80 50 the corner of secs. 26-27-34 & 35 see diagram on this Page.

as subdivided by straight lines from corner to corner on Boundarys

John W Kimbell County Surveyor

assisted by C.H. Park and R S Tucker Chainmen

Henry Sumener Flagman.