

UMATILLA COUNTY CLERK

R 191 PAGE 1019

APR 18 P 2:32

BEFORE THE BOARD OF COUNTY COMMISSIONERS  
FOR UMATILLA COUNTY, OREGON

IN THE MATTER OF VACATING THE )  
EASTERLY 5 FEET OF DELPHI STREET ) VACATION 153710  
IN THE UNINCORPORATED CITY OF )  
REITH, OREGON )

ORDER

This matter having previously come before the Umatilla County Board of Commissioners for proceedings to vacate the Easterly five (5) feet of Delphi Street, Doris Addition to the unincorporated town of Reith, Umatilla County, Oregon; and

IT APPEARING that the Director of Public Works, after reviewing the petition and coordinating with utility companies, has recommended that the said unnamed road, be vacated; and

NOW THEREFORE, BE IT AND IT HEREBY IS ORDERED AND ADJUDGED that unnamed road, shown in yellow on the assessor's map (T2N, R31 E.W.M.) which is attached hereto, and by this reference incorporated herein and made a part hereof be, and the same is, hereby vacated and that all right and title thereto subject to the rights of all public and private utility companies or easements of record, does hereby vest in the owner of the land abutting the vacated property by extension of the person's abutting boundaries, in accordance with Oregon law.

*Error  
Should be  
2N3207CC*

The county surveyor is directed to mark the plat as provided.

Dated at Pendleton, OR, this 18<sup>th</sup> day of April, 1990.


UMATILLA COUNTY BOARD OF COMMISSIONERS



*William S. Hansell*  
Commissioner Bill Hansell

*Glen Youngman*  
Commissioner Glen Youngman

*James Hughes*  
Commissioner James Hughes

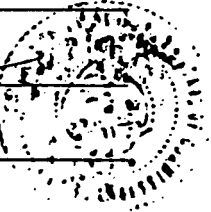

APPROVED AS TO FORM


*Jackie Hagerty-Foster*  
Jackie Hagerty-Foster  
Umatilla County Legal Counsel

ORDER - Page 1

VAC-ORD6-03-90

4/23/90

R191 REF 1020

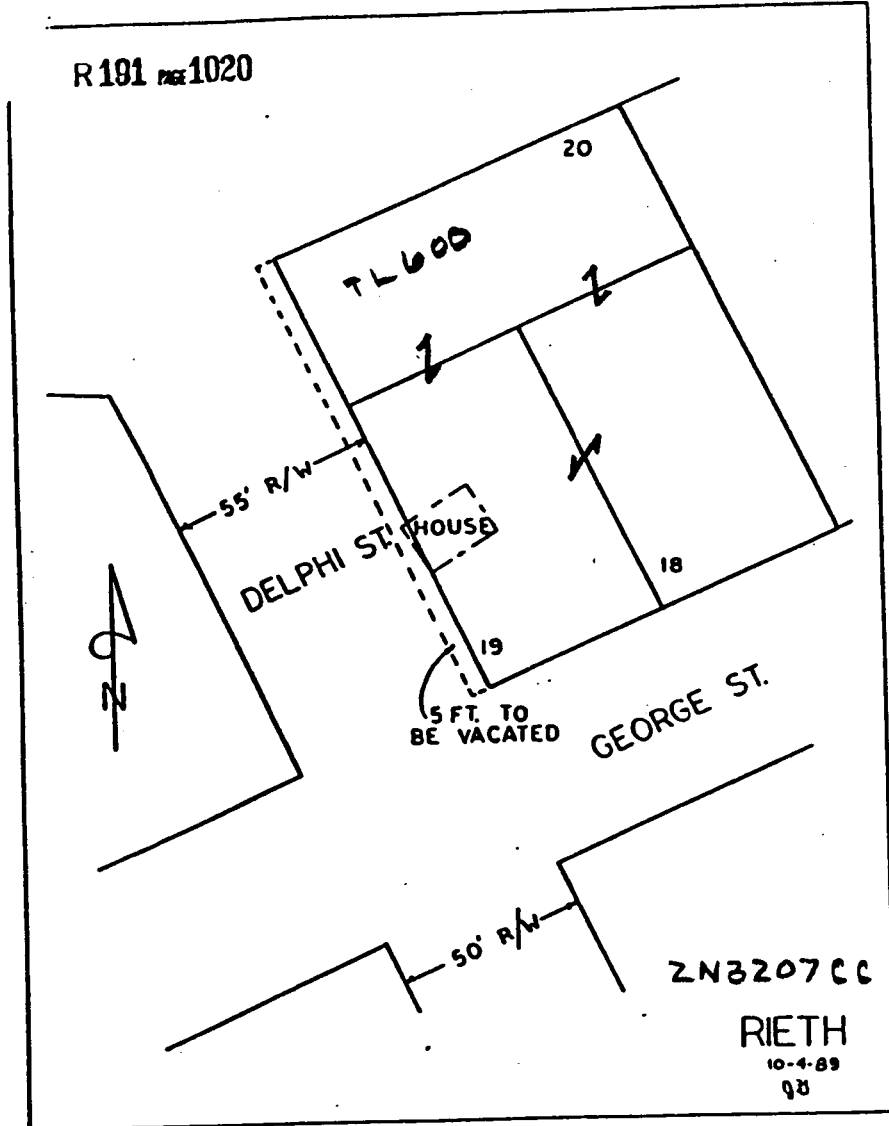

4/23/90

UMATILLA COUNTY CLERK

1990 APR 23 A 10: 14

R 191 PAGE 1021

STATE OF OREGON,  
COUNTY OF UMATILLA,  
I, Joyce Onda, County Clerk, certify that this  
instrument was received and recorded

ON APR 23 1990

at 10:14 a.m. in the record  
book of said County in

Book Page  
R 191 1019  
UMATILLA COUNTY CLERK  
Joyce Onda

By: *[Signature]*  
Joyce Onda  
County Clerk  
Form 1, XX No. 157710

Commissioners Journal  
(Rev)