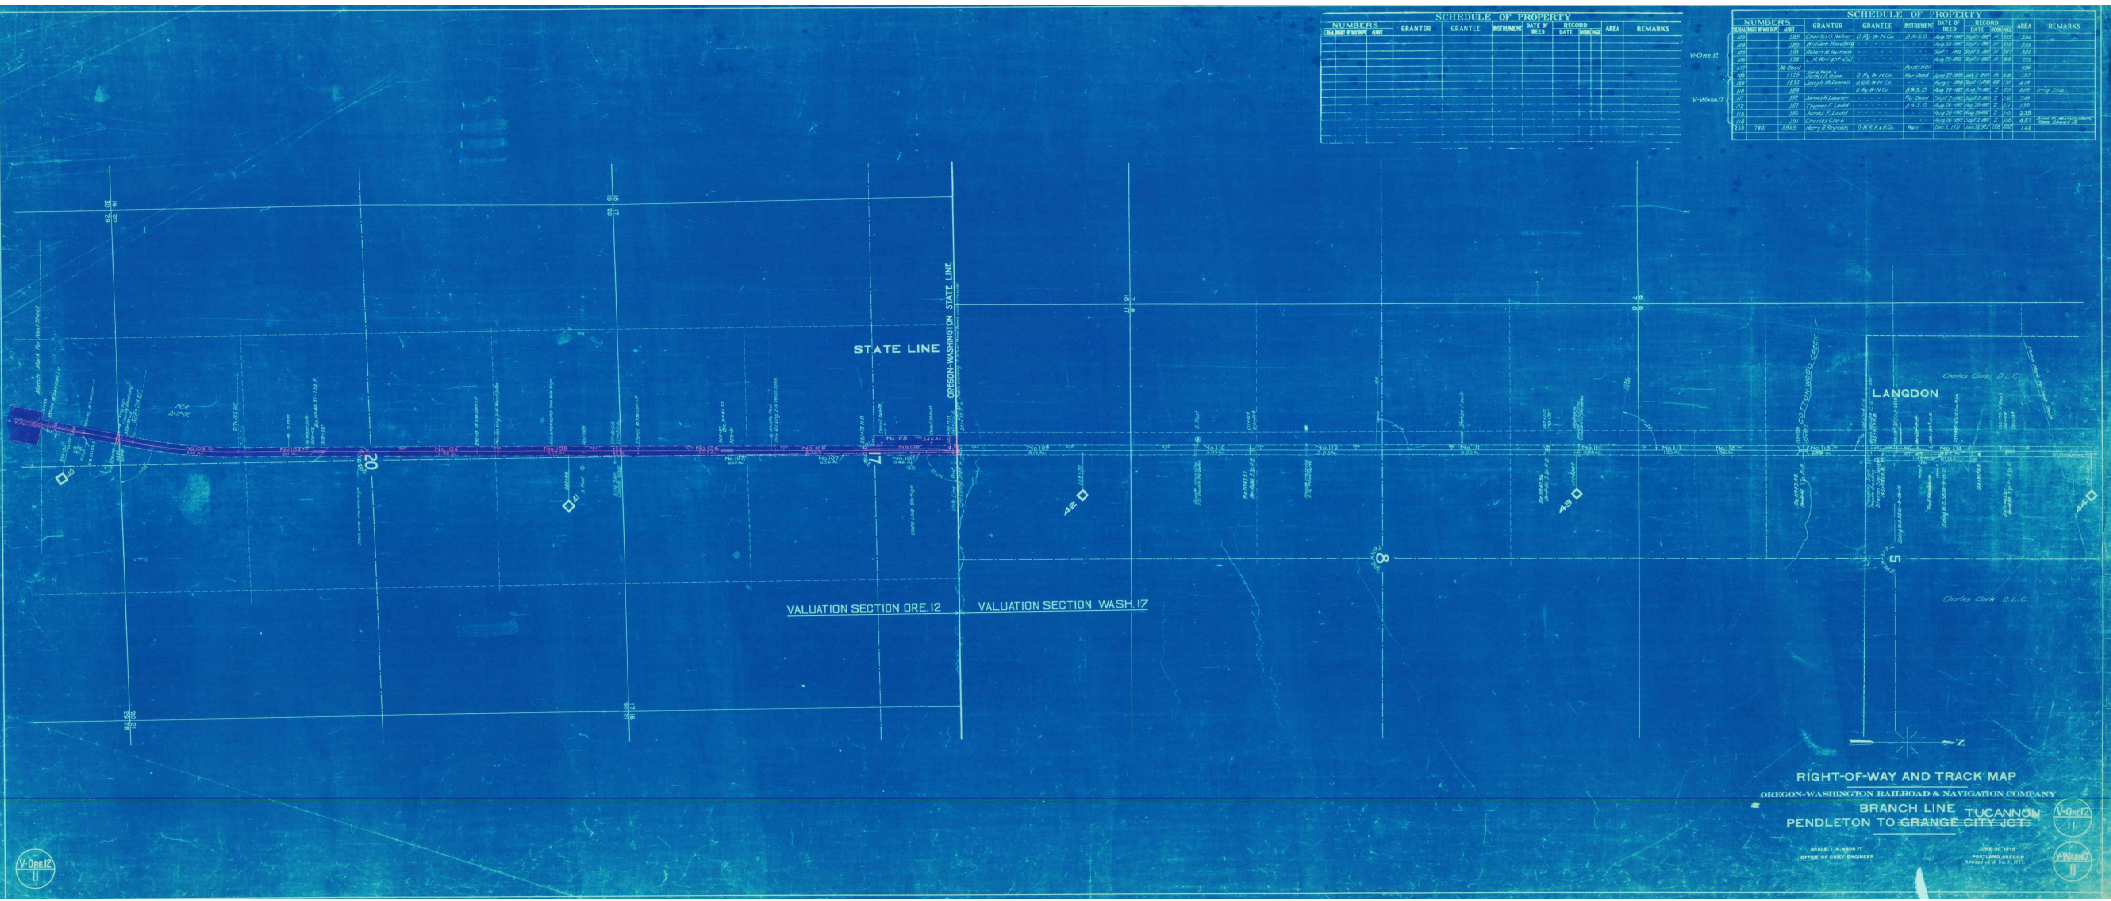
SCHEDULE OF PROPERTY
NUMBERS
GRANTOR
GRANTEE
INSTRUMENT
DATE OF DEED
RECORD
AREA
REMARKS
V-ORE.12
V-WASH.17
SCHEDULE OF PROPERTY
NUMBERS
GRANTOR
GRANTEE
INSTRUMENT
DATE OF DEED
RECORD
AREA
REMARKS
STATE LINE
OREGON-WASHINGTON STATE LINE
LANGDON
Charles Clark D.L.C.
VALUATION SECTION ORE. 12
VALUATION SECTION WASH. 17
RIGHT-OF-WAY AND TRACK MAP
OREGON-WASHINGTON RAILROAD & NAVIGATION COMPANY
BRANCH LINE TUCANNON
PENDLETON TO GRANGE CITY JCT.
V-ORE.12
11
V-WASH.17
11