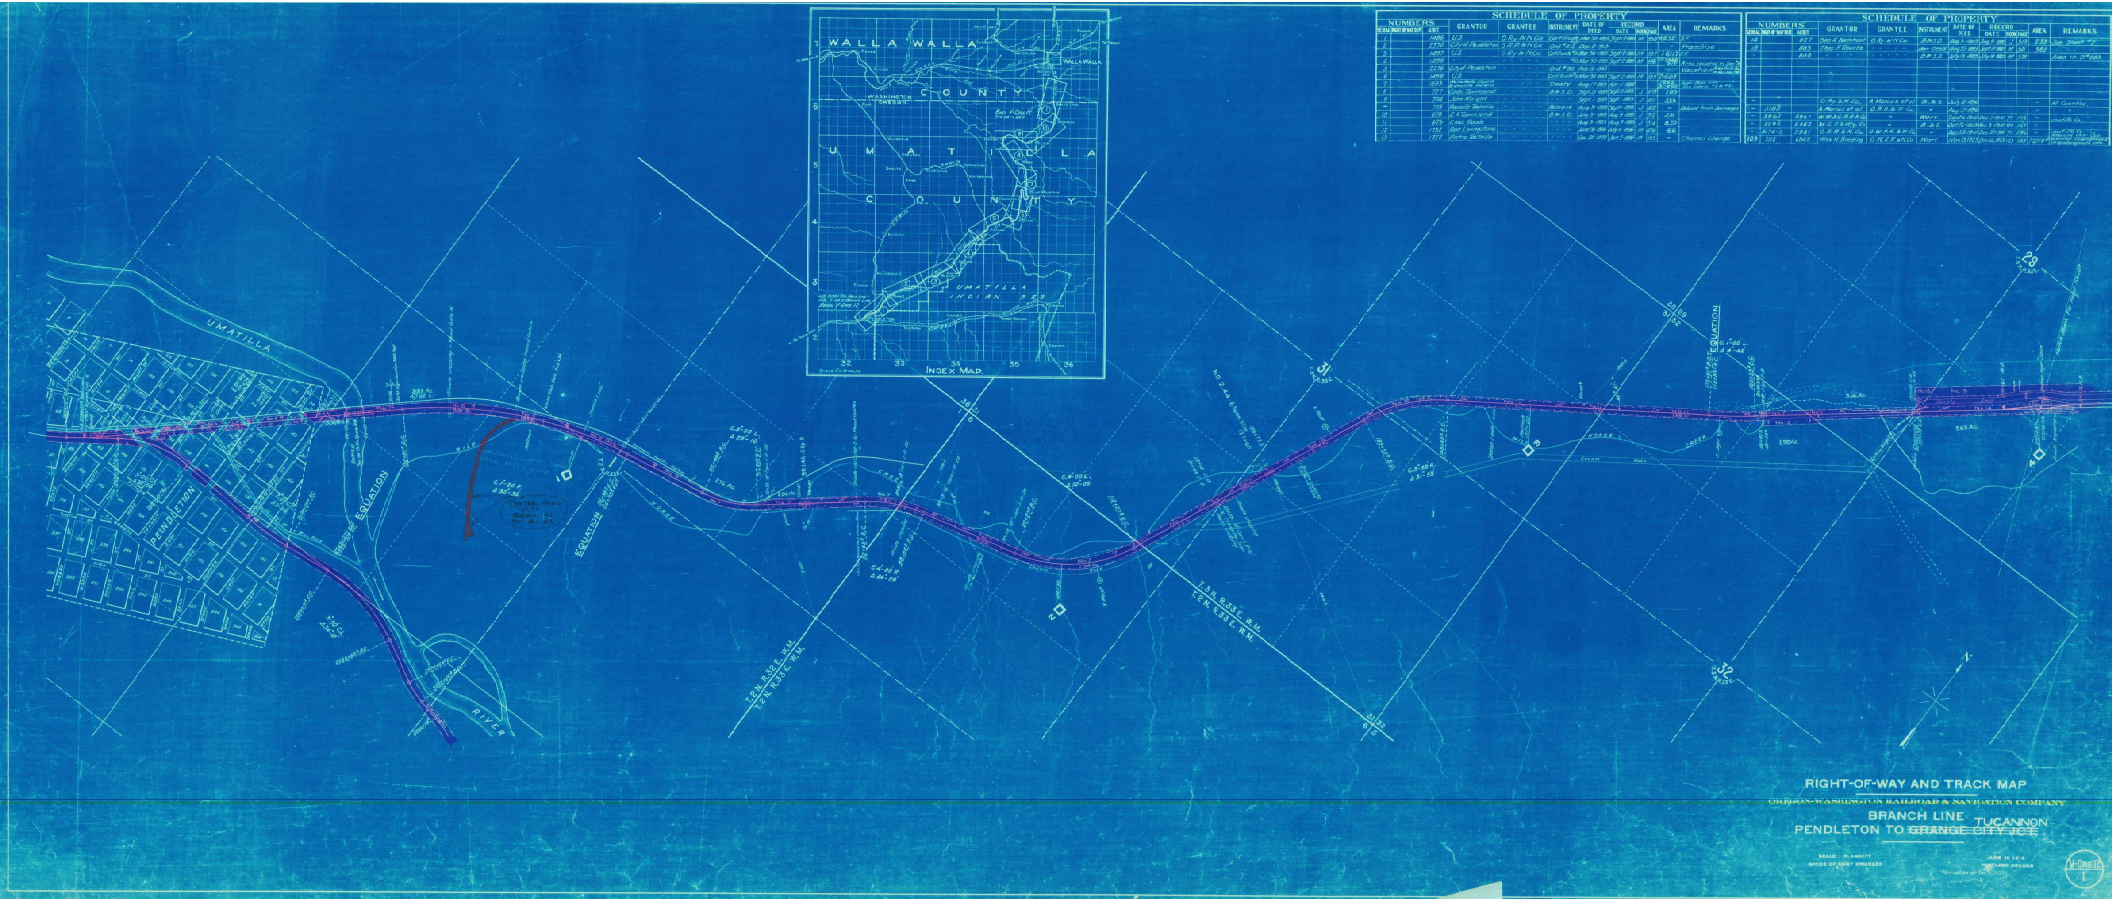
WALLA WALLA
COUNTY
UMATILLA
COUNTY
WASHINGTON
OREGON
WALLA WALLA
UMATILLA INDIAN A.R.D.
INDEX MAP.
UMATILLA
PENDLETON
EQUATION
EQUATION
EQUATION
RIVER
12N. R32E. W.M.
12N. R33E. W.M.
12N. R34E. W.M.
SCHEDULE OF PROPERTY
SCHEDULE OF PROPERTY
RIGHT-OF-WAY AND TRACK MAP
OREGON-WASHINGTON RAILROAD & NAVIGATION COMPANY
BRANCH LINE TUCANNON
PENDLETON TO GRANGE CITY ~~ICE~~