Form 2085

B-19-3

45

Scale 400 ft. 1 Inch

N. P. Ry.

Wallula to Pendleton *Right of Way Plat*

State of Oregon *County of* Umatilla

Section 31 *Township* 3 North *Range* 33 East *of* Willamette *Meridian*

NOV 1 1960

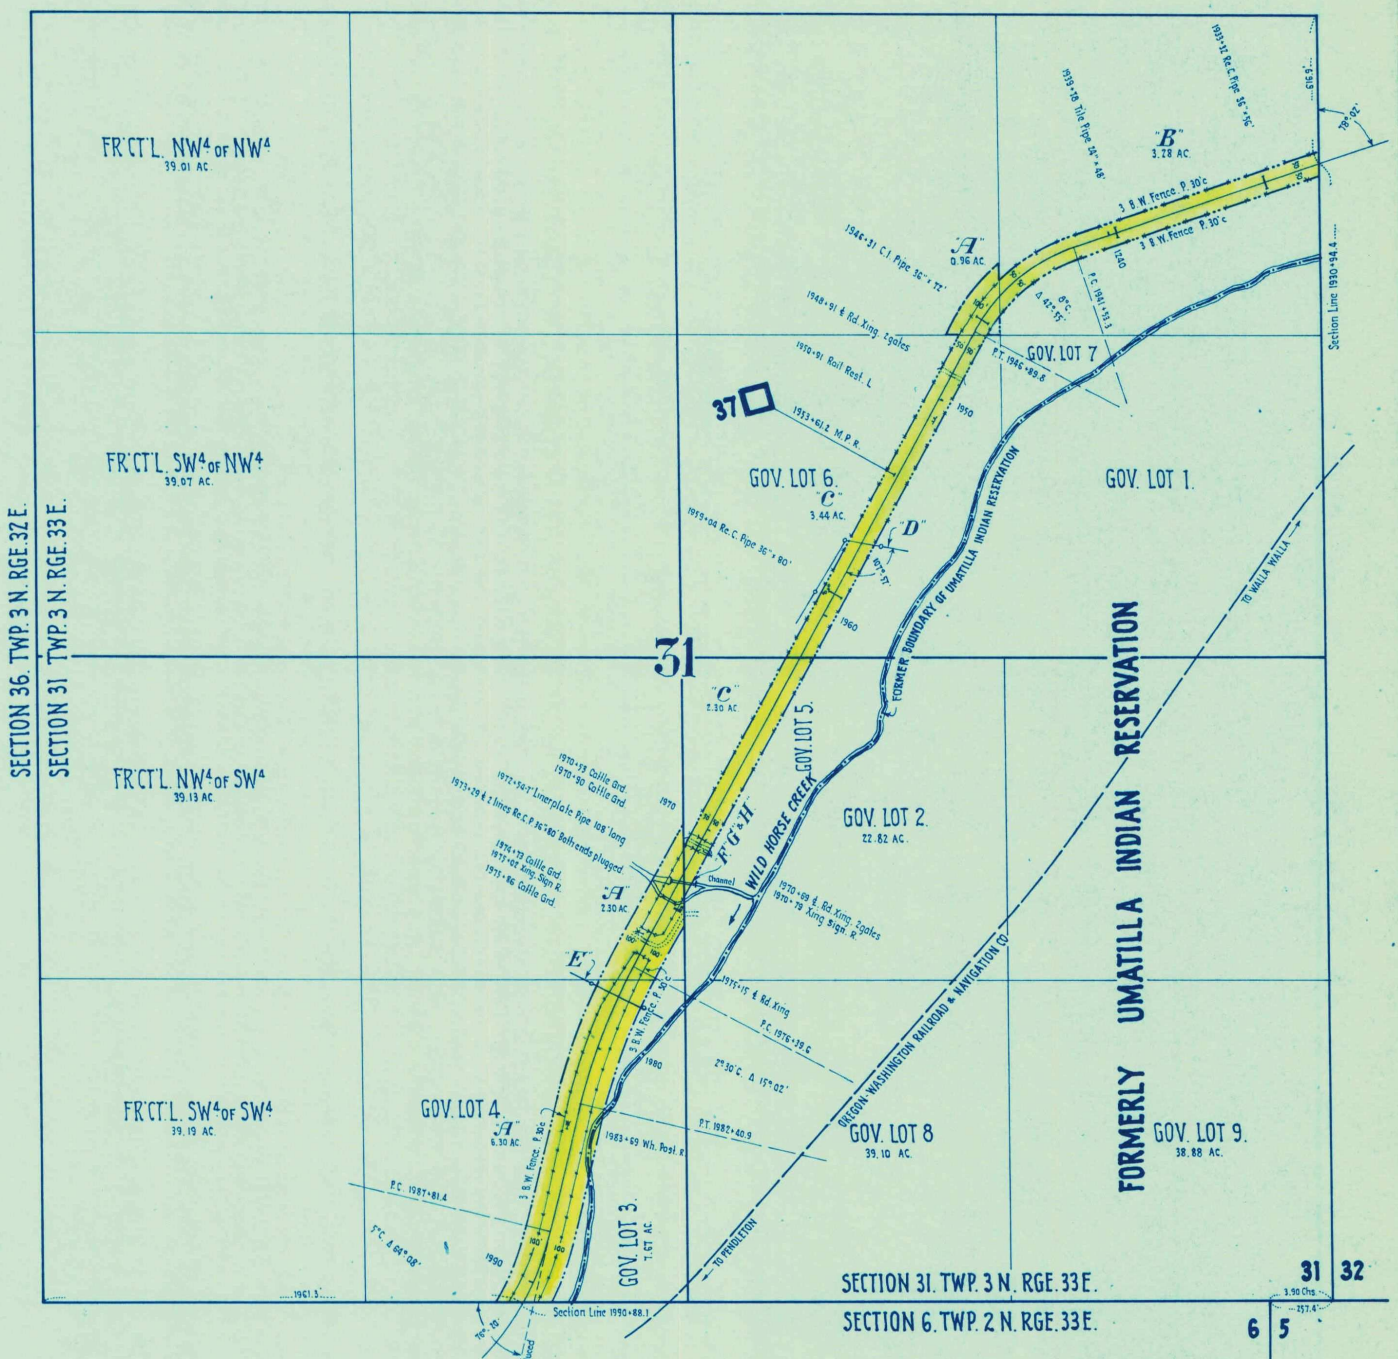

	W. No.	Deed No.	Grantor	Grantee	Title	Acres	Date	Recorded	Brief Description	Cor. File	R/W Memo.
A		Eng. Dep. Map 361-10	United States of America.	Oregon & Washington Territory Railroad Co.	Act of Congress		Mar. 3. 1875	Map filed in Local Ld. Off. Nov. 29. 1887 Approved Oct. 27. 1887.	200' R/w. across NW4 of NE4; Gov. Lots 3 & 4, and NE4 of SW4		
B		53	George M. Harrah & wf.	O. & W. T. RR. Co.	R/w. Deed.		June 5. 1889.	June 5. 1889. Bk. W. Deeds. P. 154	100' R/w. across Gov. Lot 7. and NE4 of NE4		
C		56	Alamanda E. Townsend	O. & W. T. RR. Co.	R/w. Deed.		Aug. 10. 1889	Aug. 13. 1889. Bk. W. Deeds. P. 445	100' R/w. across Gov. Lots 5, 6, & 7.		
D		116	Northern Pacific Ry. Co.	Pacific Power & Light Co.	Permit.	Nº 45480	Feb. 15. 1928		Power Line Xing 305 ft. SW'ly. from M.P. 37	18540	
E		117	Northern Pacific Ry. Co.	Pacific Power & Light Co.	Permit	Nº 45834	June 15. 1928	Transferred to Lease 45894.	Power Line Xing. 2405 ft. SW'ly. From. M.P. 37	18654	
F	W-12875	144	James Rutten & wf.	N. P. Ry. Co.	Easement & Release		Apr. 24. 1950	*Note* This easement corrected. See Deed 1448 May 10. 1950. Bk. 192 Deeds. P. 417	Right to construct 84" culvert and concrete cut-off wall in Gov. Lot 5. Also releases Ry. Co. from claims caused by construction etc. of existing 36" culverts and said 84" culvert.	21790	81/50.
G		144 A	Northern Pacific Ry. Co.	James Rutten & wf.	Agreement		May 12. 1950		Covering installation and maintenance of 84" culvert in Gov. Lot 5.	21790 A.S. Doc. 20604	
H	W-12875 A.	144 B.	James Rutten & wf.	N. P. Ry. Co.	Easement & Release		July 11. 1950	Aug. 2. 1950. Bk. 193 Deeds. P. 487.	Same description as in Deed 144. *NOTE* Corrects Deed Nº 144.	21790	
I											
J											
K											
L											
M											