



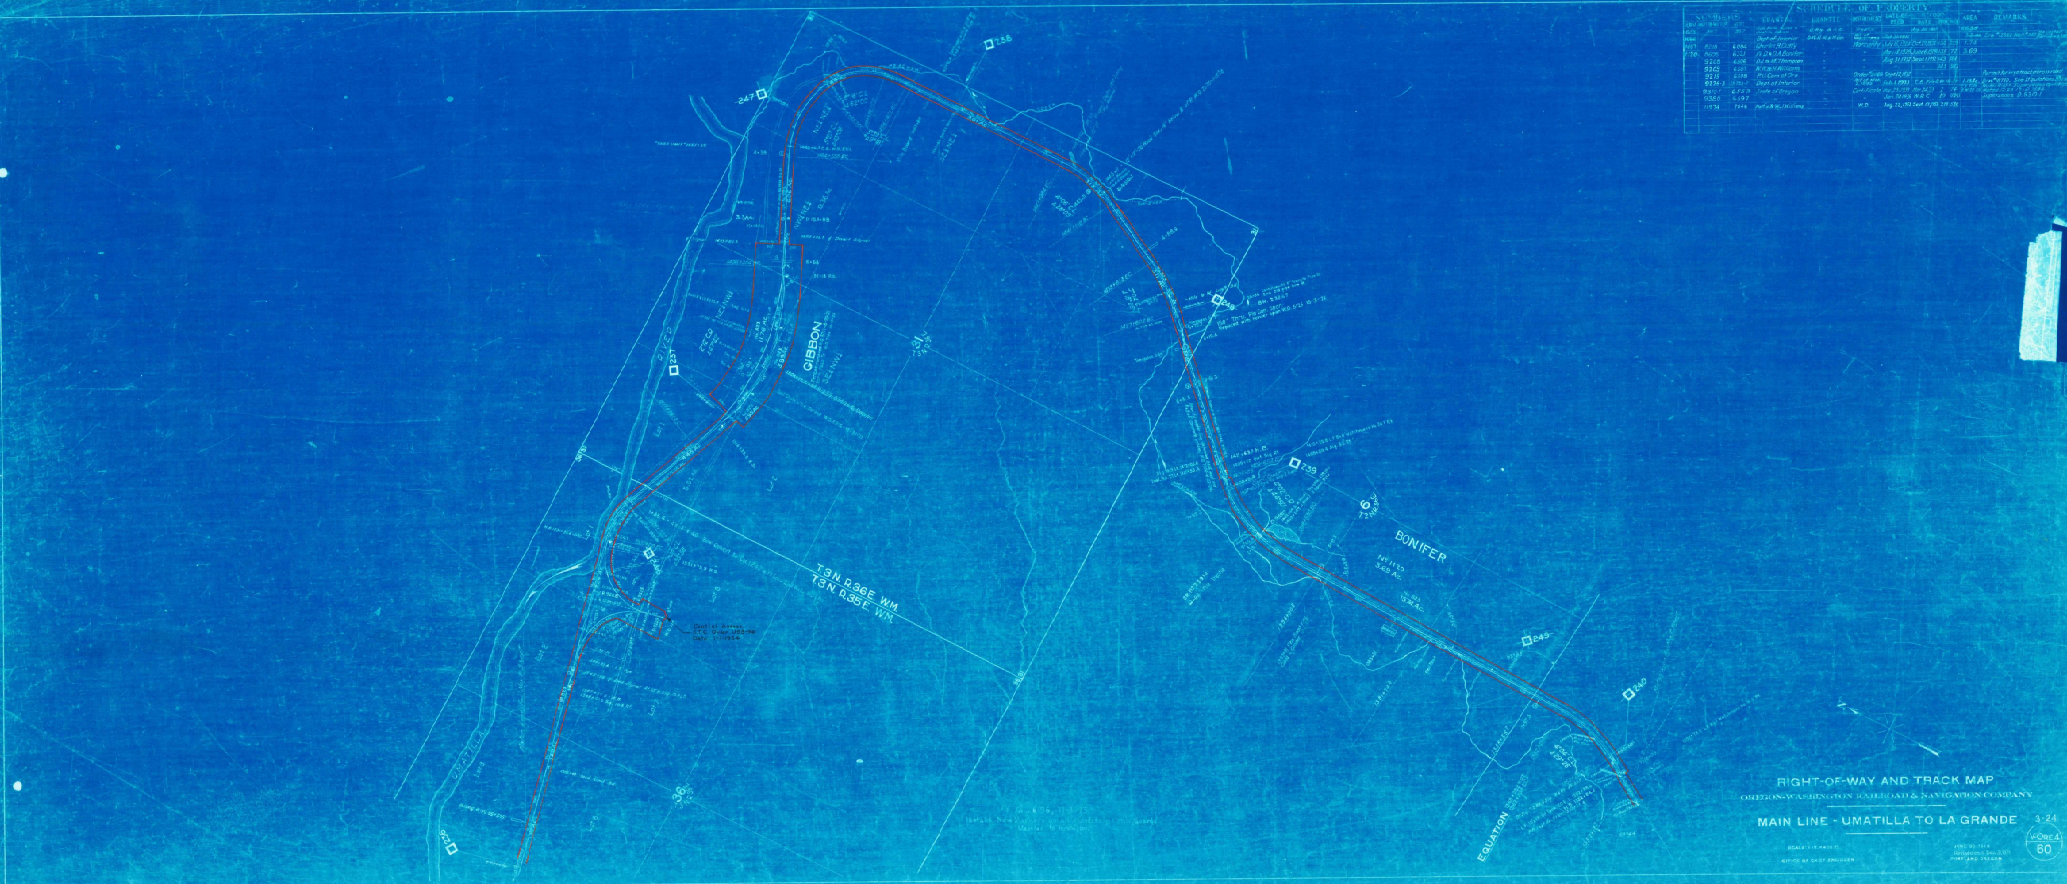

T3N R36E WM
T3N R35E WM

BOWIFER
SECTION 6
T3N R36E WM

RIGHT-OF-WAY AND TRACK MAP

MAIN LINE - UMATILLA TO LA GRANDE


3-24
60