



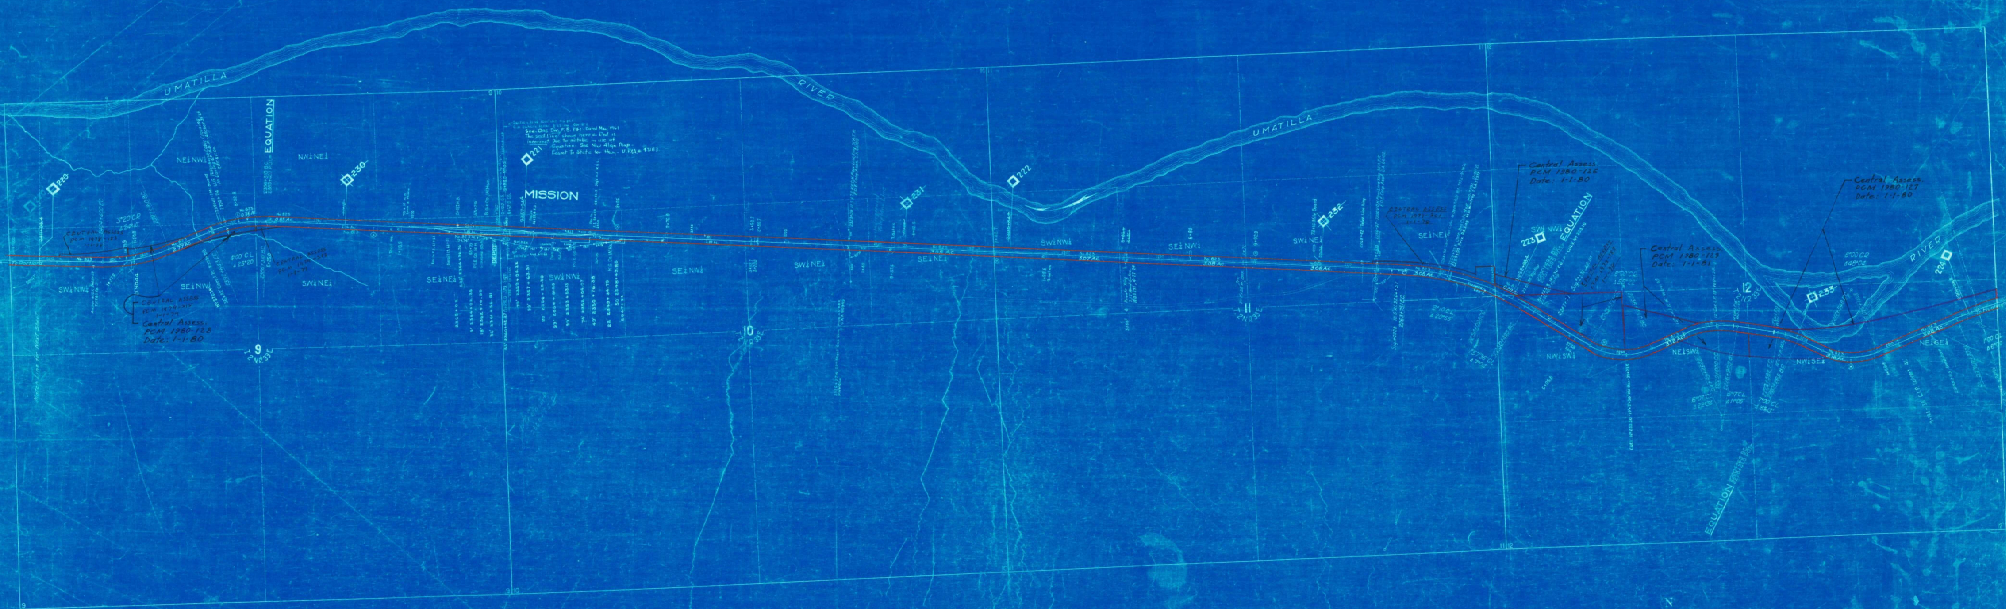

AS 159, 1960




320
 56