SCHEDULE OF PROPERTY											
NUMBERS			GRANTOR	GRANTEE	INSTRUMENT	DATE OF DEED	RECORD			AREA	REMARKS
SERIAL	RIGHT OF WAY DEPT.	AUDIT					DATE	BOOK	PAGE		
823	357	357	Walla Walla Cayuse & Umatilla Indians	O. Ry. & N. Co.	Treaty	Aug.26 1881	–	–	–	60.23	
1082	2123	6043	Umatilla County Court	O-W.R.R. & N.Co.	Court Order	Nov. 21, 1923	–	–	–		Franchise
	8582	357	Martin & Mary Madison	do.	Decree	Jan 21 1927	–	–	–	–	Confirms right to 150 strip & 35 Ac. sta grounds
–	–	–	–	–	–	–	–	–	–	–	attached to D.8582) addition to amt. under treaty
1083	–	–	U.S.	Act of Congress of Mch 2, 1899. Approved 5-14-28						0.67 Ac.	Included in 1927 inventory
1127	–	–	"			"	"			0.42 Ac.	Slopes
	9310-1	6553	State of Oregon	O.W.R.&N.Co	Certificate	Nov. 23, 1933	Nov. 24, 33	2	74	C.E. File S.W. 20-29	Water Right. Supersedes Certificate of 11-29-19 - D.7984
	9380	6597	"	"	"	Jan. 24, 1935	W.R.C.	10	11093		Supersedes D.9310-1
	10421	7067	Umatilla County Court	O.W.R. & N. Co.	Easement	Sept. 2, 1943	Oct. 7, 1943	Vol 170	118		Water Intake Ditch
	10440	58399	Jerry Johnley & Wife	O.W.R & N. Co.-U.P.	Permit	Sept. 10, 1943	Dec. 1, 1943	Vol 170	138		Water Intake Ditch
	10440-1	58399-2	Jerry Johnley	do	Release Agmt.	Dec. 23, 1948	June 14, 1949	189	304		Cancels D. 10440

✱ Reduction in area due to line change

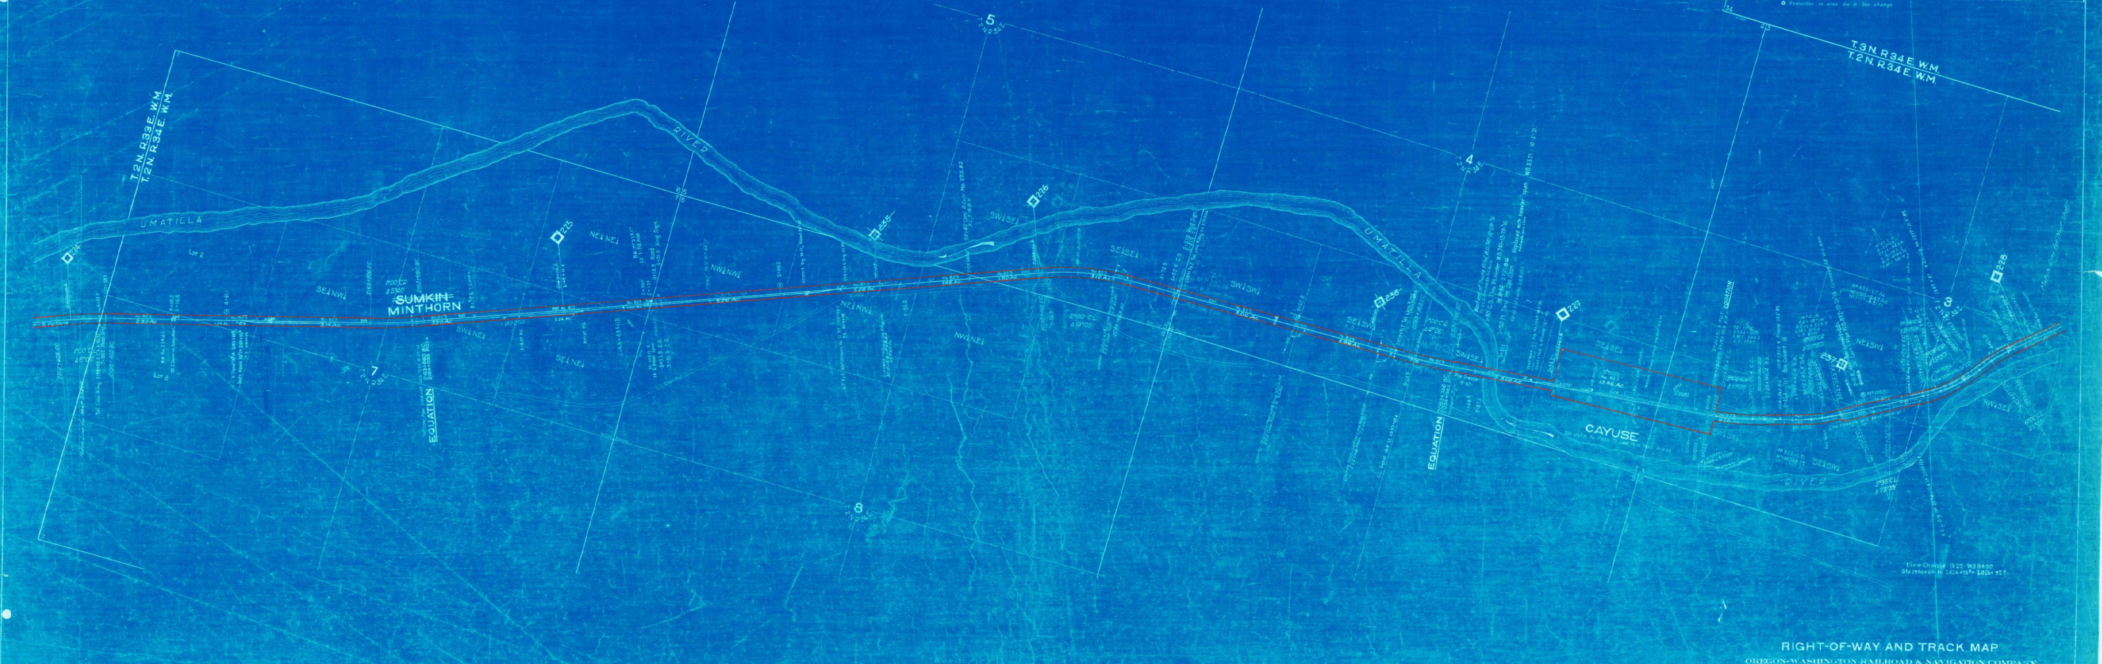

RIGHT-OF-WAY AND TRACK MAP

OREGON-WASHINGTON RAILROAD & NAVIGATION COMPANY

MAIN LINE - UMATILLA TO LA GRANDE

3-21

SCALE: 1 IN. = 400 FT.

OFFICE OF CHIEF ENGINEER

JUNE 30 1916
Revised as of Dec. 31, 1917
PORTLAND OREGON

V-ORE. 4
57