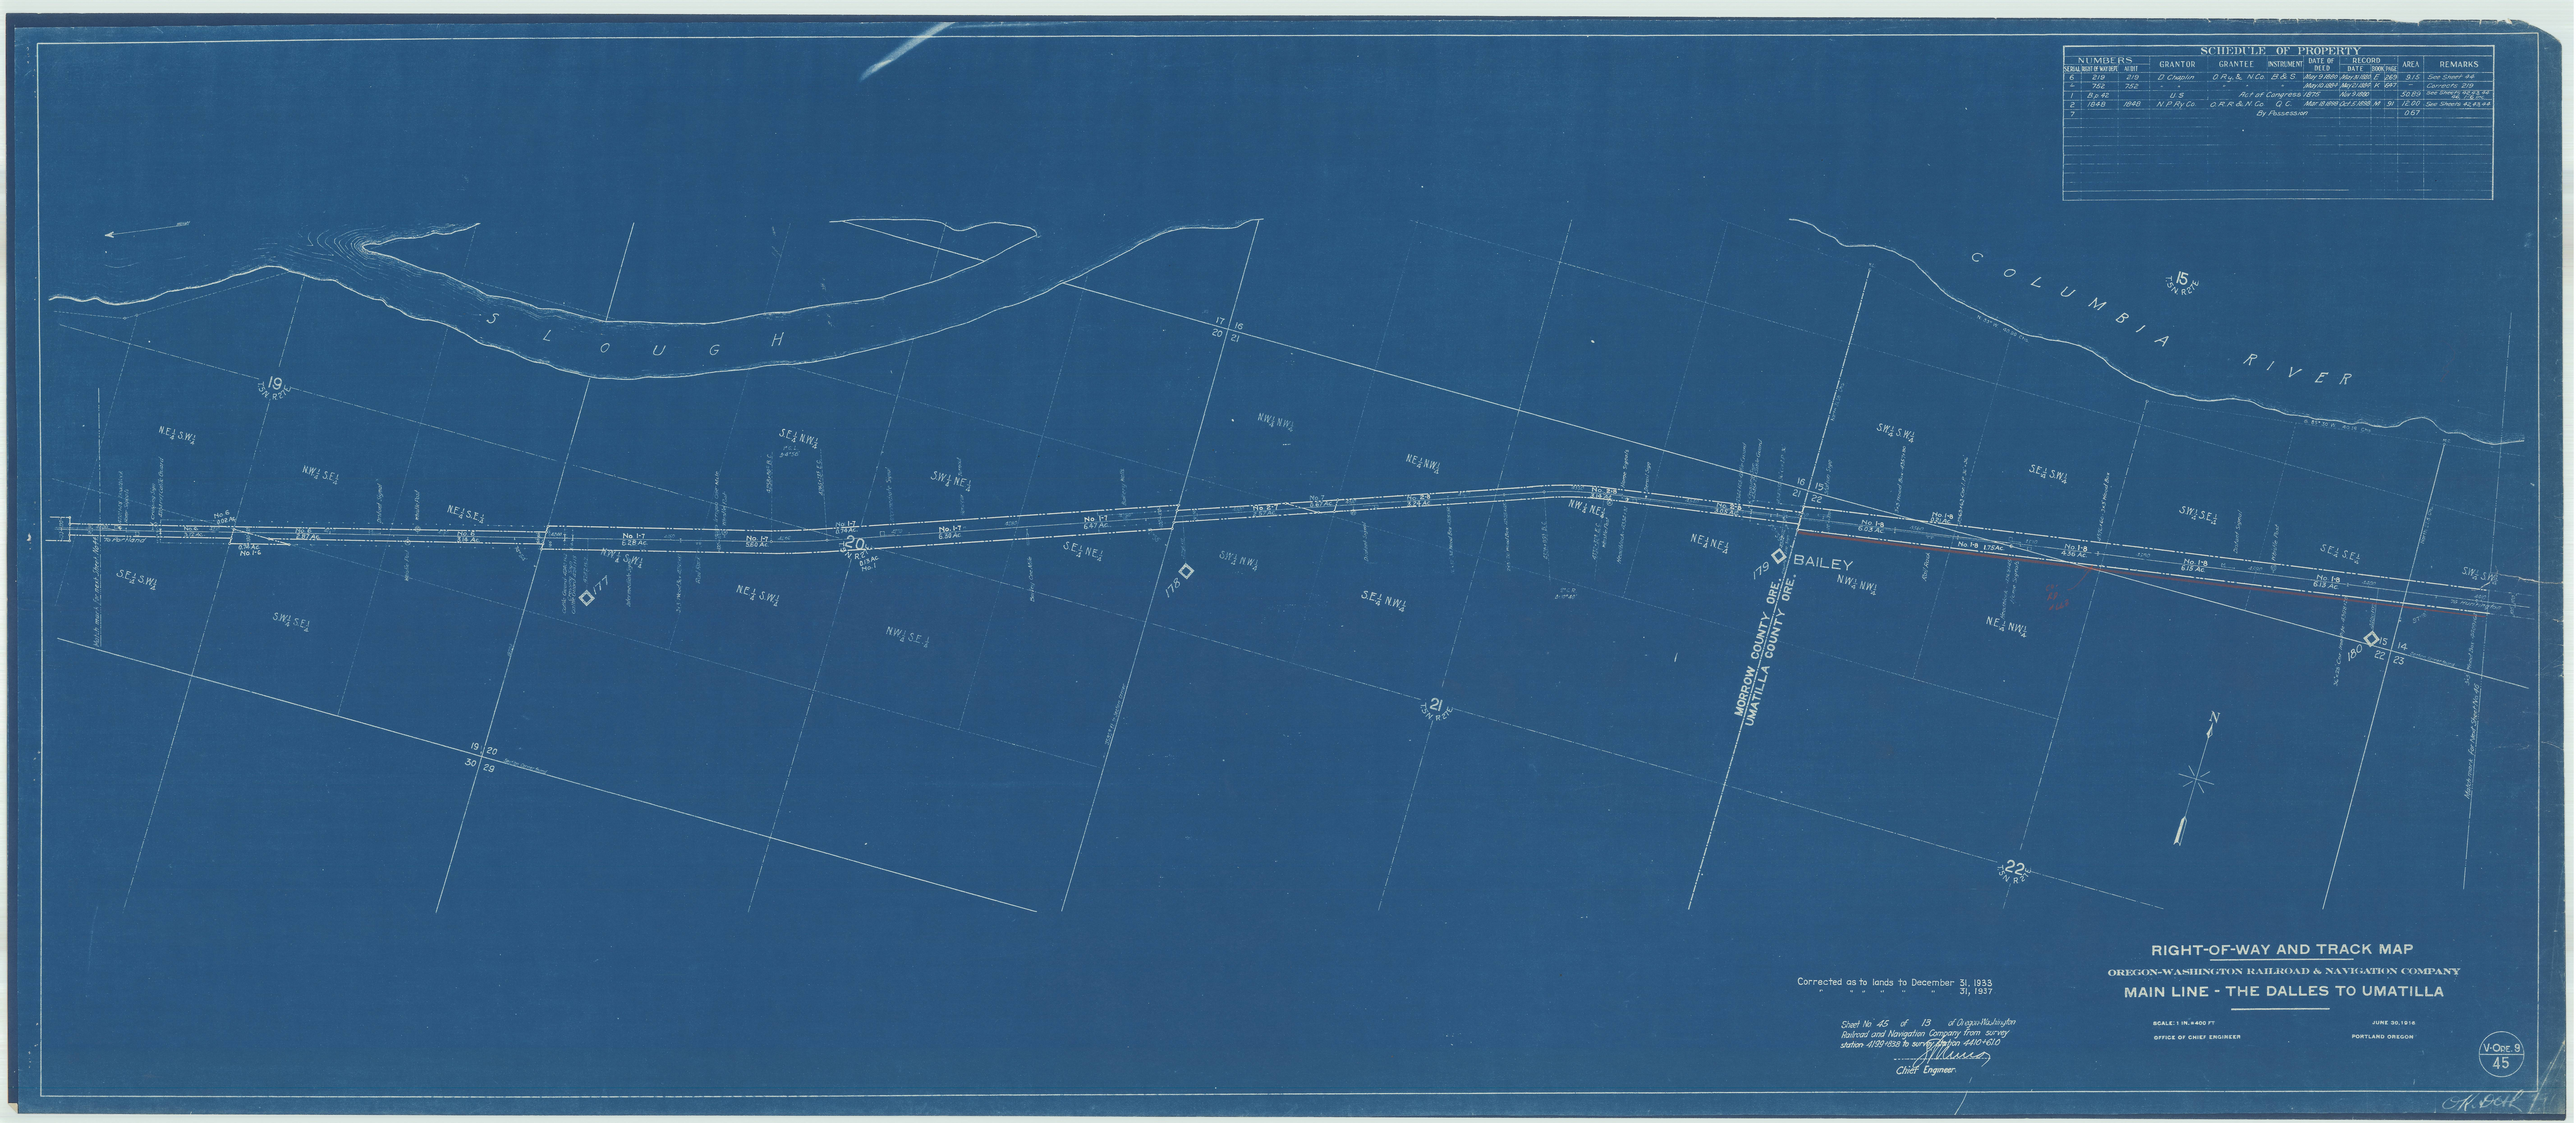
SCHEDULE OF PROPERTY
NUMBERS
SERIAL NO. OF WAY DEPT. | AUDIT | GRANTOR | GRANTEE | INSTRUMENT | DATE OF DEED | RECORD DATE | RECORD BOOK | PAGE | AREA | REMARKS
6 | 219 | 219 | D. Chaplin | O. Ry. & N. Co. | B & S. | May 9 1880 | May 16 1883 | E | 269 | 9.15 | See Sheet 44
4 | 752 | 752 | " | " | | May 10 1884 | May 21 1885 | K | 647 | | Corrects 219
1 | B.p. 42 | | U.S. | | Act of Congress 1875 | | Nov 9 1888 | | | 50.89 | See Sheets 42, 43, 44, 45, 46, 47
2 | 1848 | 1848 | N.P. Ry. Co. | O.R.R. & N. Co. | Q.C. | Mar 18 1898 | Oct 5 1898 | M | 91 | 12.00 | See Sheets 42, 43, 44
7 | | | By Possession | | | | | | | 0.67 | |
SLOUGH
COLUMBIA RIVER
BAILEY
MORROW COUNTY ORE.
UMATILLA COUNTY ORE.
N
Corrected as to lands to December 31, 1933
" " " " " " 31, 1937
Sheet No. 45 of 19 of Oregon-Washington Railroad and Navigation Company from survey station 4199+838 to survey station 4410+616
Chief Engineer
RIGHT-OF-WAY AND TRACK MAP
OREGON-WASHINGTON RAILROAD & NAVIGATION COMPANY
MAIN LINE - THE DALLES TO UMATILLA
SCALE: 1 IN. = 400 FT
JUNE 30, 1916
OFFICE OF CHIEF ENGINEER
PORTLAND OREGON
V-ORE. 9
45