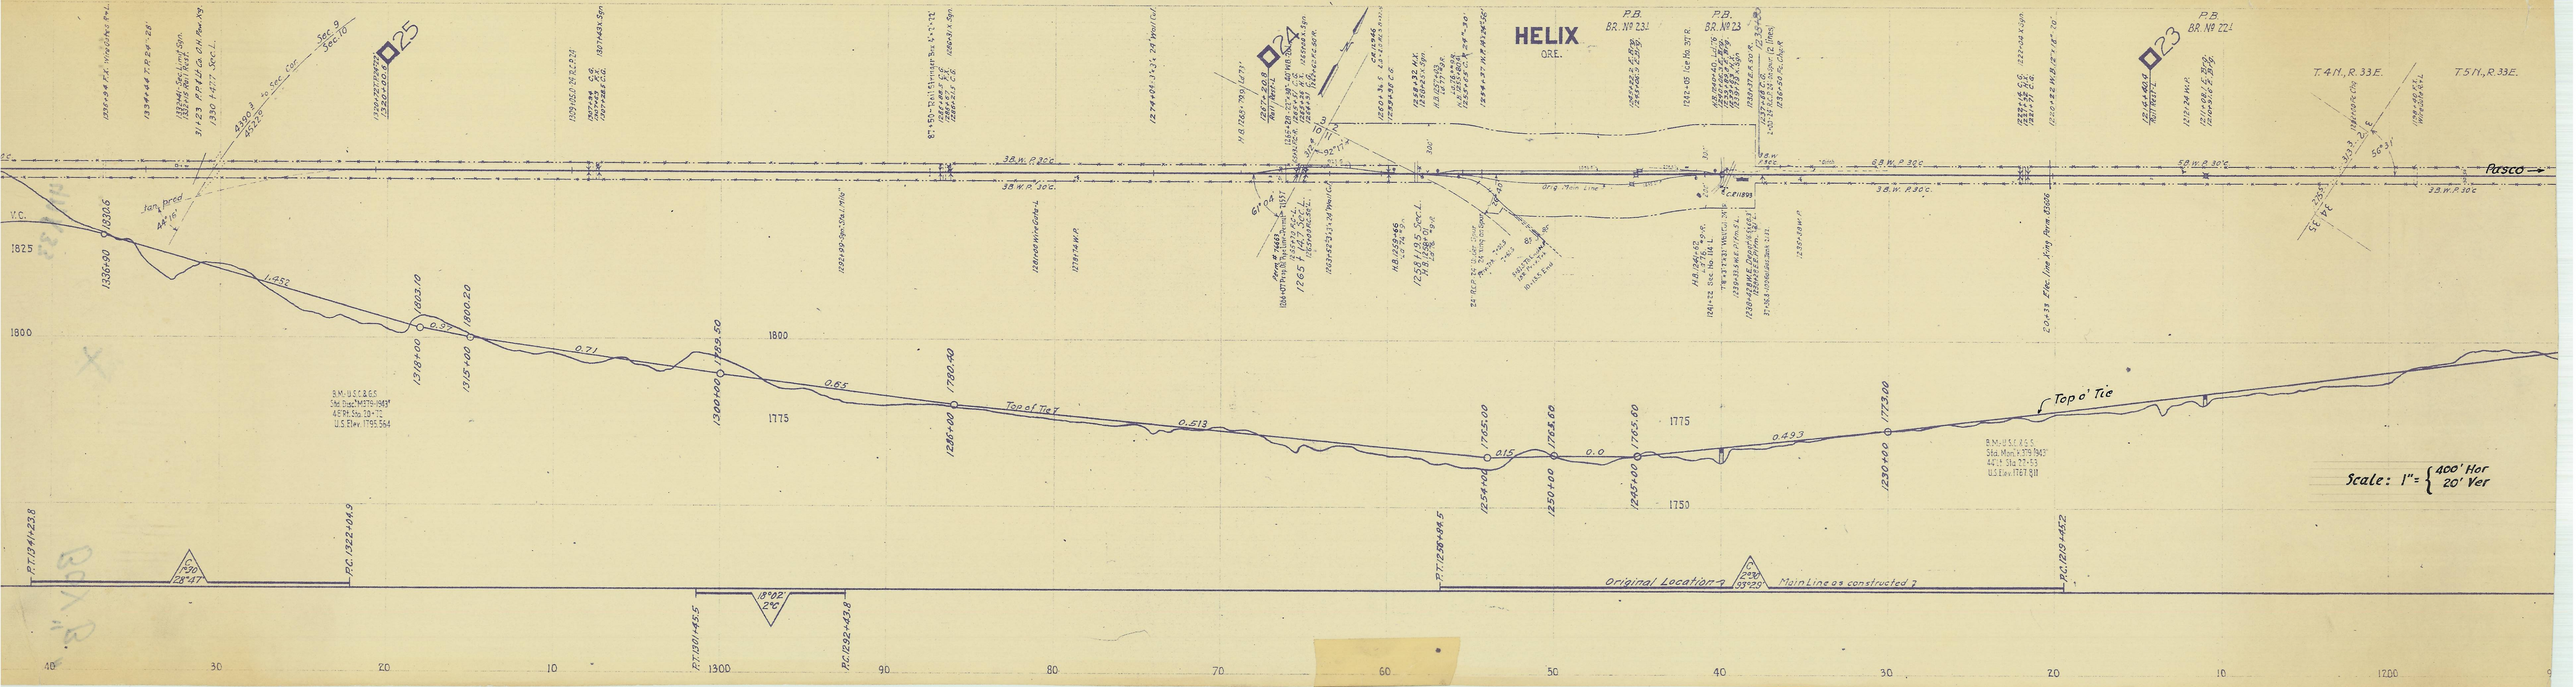
HELIX
ORE.
Pasco
Top o' Tie
Top of Tie 7
Original Location
Main Line as constructed
Scale: 1" = 400' Hor 20' Ver
T.4N., R.33E.
T.5N., R.33E.
P.B. BR. No 23
P.B. BR. No 22
P.B. BR. No 23
25
24
23
1825
1800
1775
1750
1300
1200