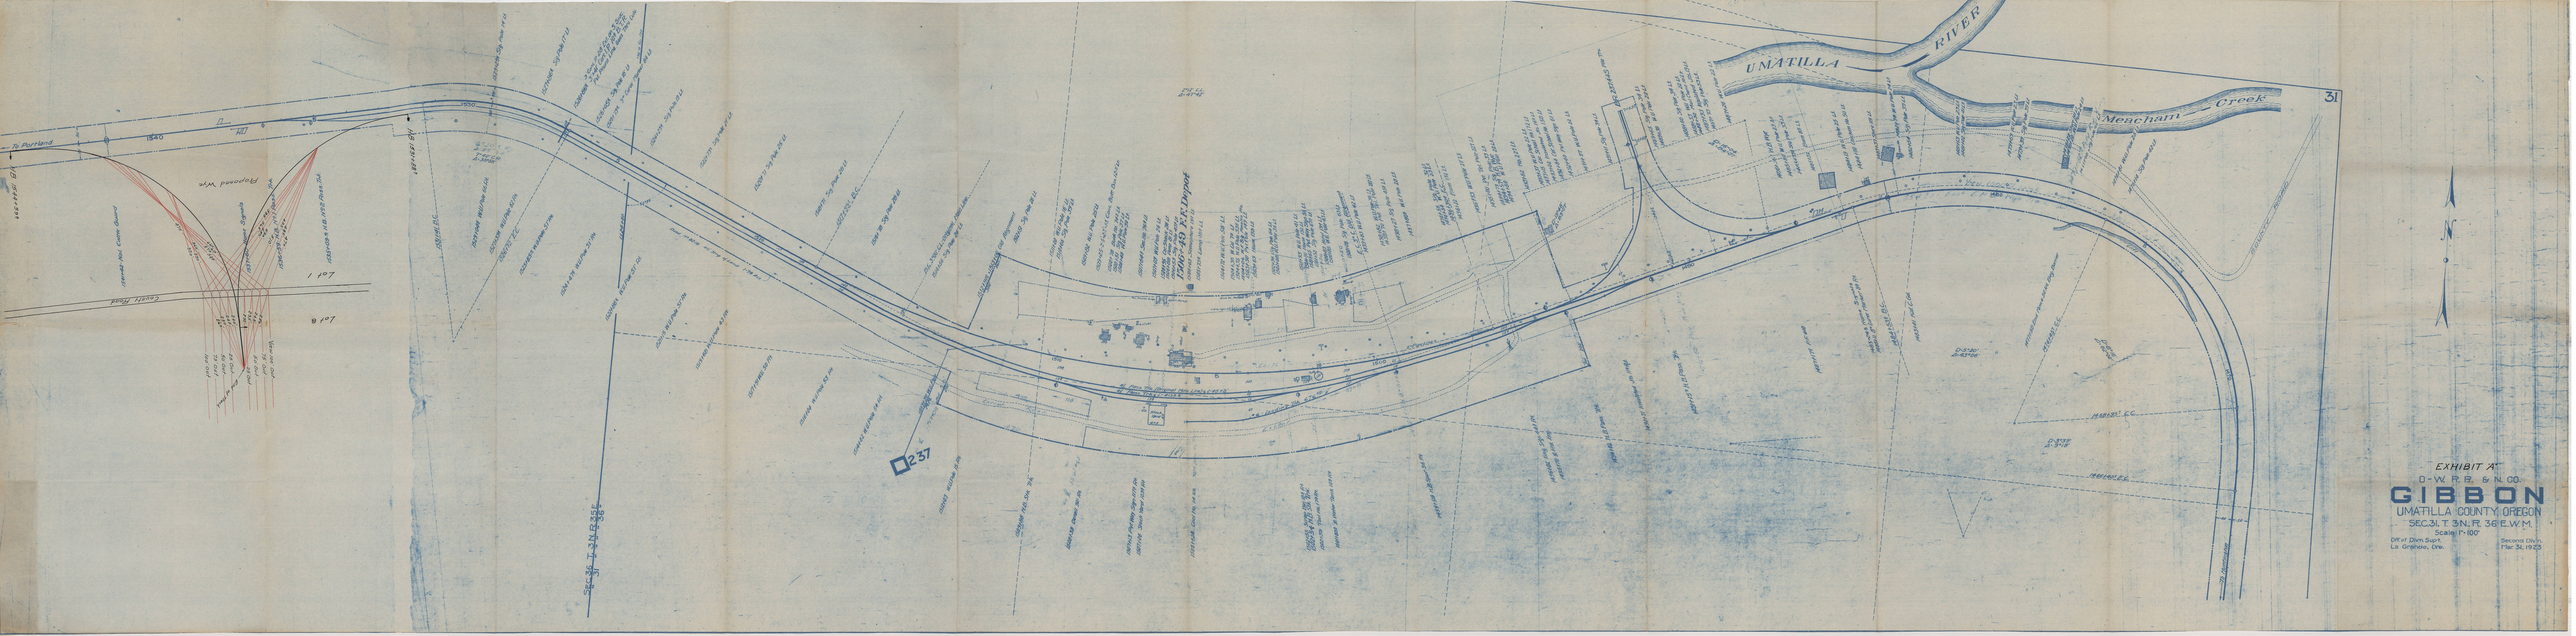

EXHIBIT "A"
O.-W. R. R. & N. CO.
GIBBON
UMATILLA COUNTY, OREGON
SEC. 31, T. 3 N., R. 36 E. W.M.
Scale: 1" = 100'
Diff. of Dim. Supt.
La Grande, Ore.
Second Div.
Mar. 31, 1923