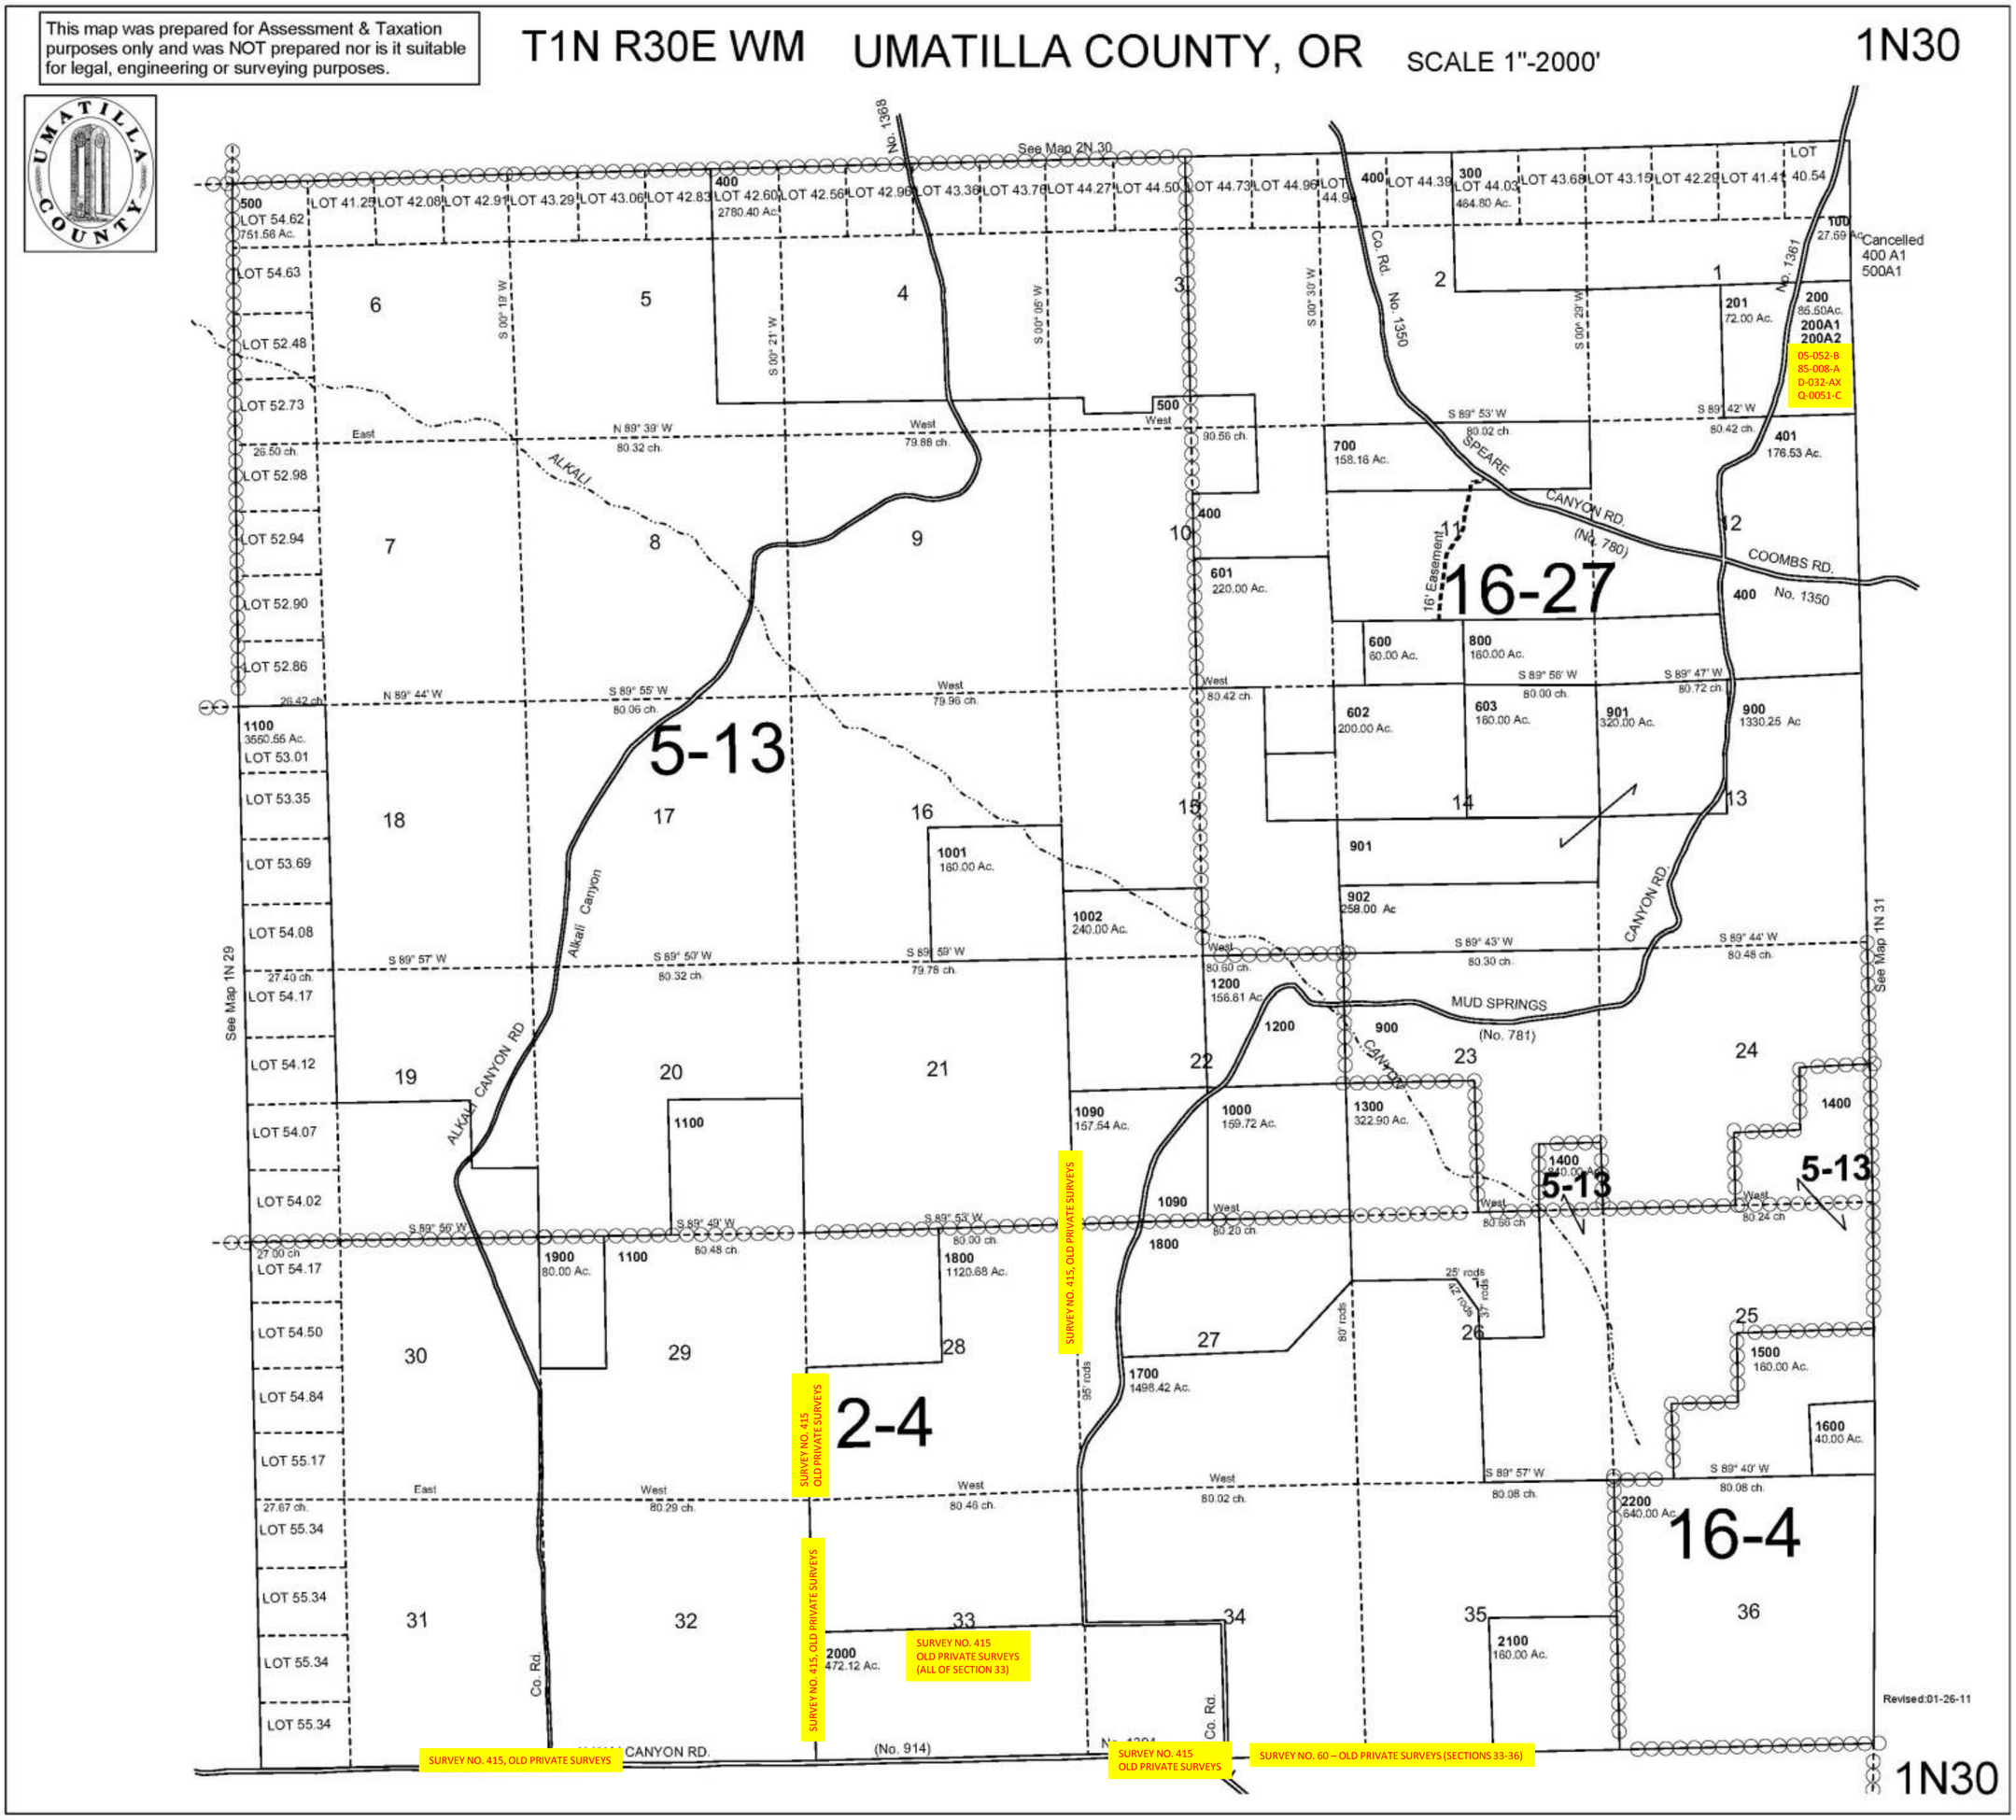ALSO SEE SURVEYS 01-206-C, 05-111-C, 07-260-C, 07-276-C, 11-063-C; CORNER RECORDS; G.L.O. SURVEYS