

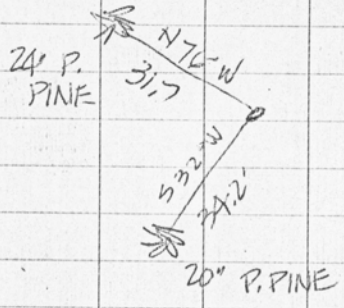


NE 1/16  
S. 29  
T. 15. R. 25

NE 1/16  
S. 29  
T. 15. R. 25

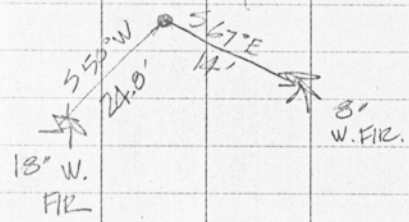

T. 15. R. 25 E  
SW 1/16  
S. 31

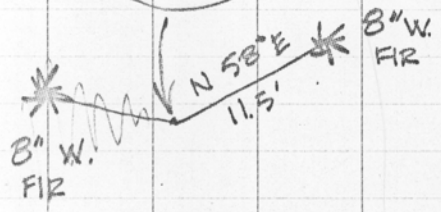

T. 15. R. 25 E  
SE 1/16  
S. 31

