


9	39.80 216	39.58 22	39.30 15	48 22 28	39.46
19	39.46	39.30	39.42	84	39.70
5	39.88	39.48	54	42	79.16
	80		72	54	
	25		36	12	

Sec. 25 T. 1 N R. 33 E

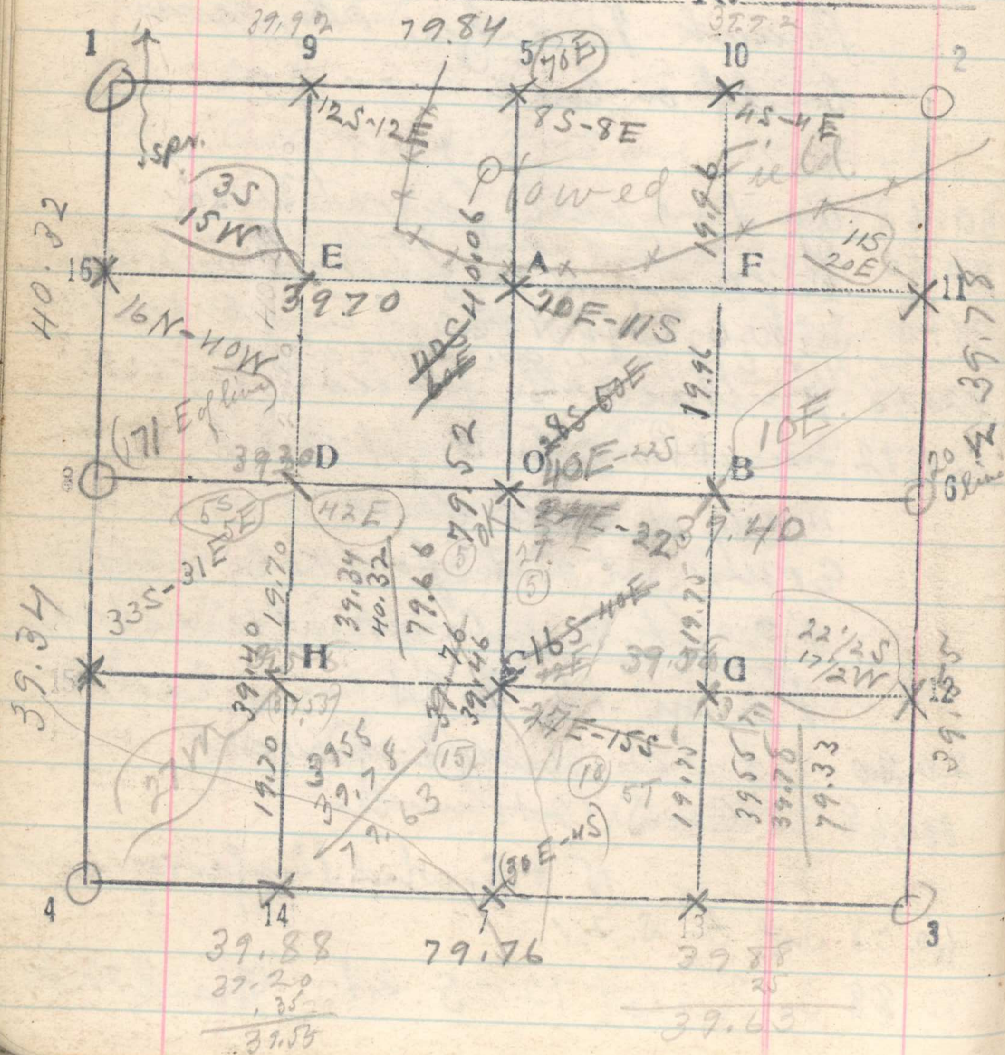

From Cor of 25. 26. 31 & 36
run Non E body Sec 25 105

20 Set 1/16 cor
39.55 1/4 cor bet 25 & 30 bears W, 35 lbs.

This cor is an iron post marked W.C.
with rocks around it but no stone
marked. MS w/c cor

Thence N. by B Son see cor.

20 Set 1/16 cor
32.50
39.78 Fence S 75° W enter plowed field.
Cor of 25 & 30 bears 19.24, 25 & 30 bears
E. 16 lbs. 40 lbs. A post in plowed
field

Thence West in plowed field

20 Set 1/16 cor.

40 Set 1/4 cor.

49.50 Fence N 30 E leave plowed field

60 Set 1/16 cor

79.84 Cor of 25, 26, 35 & 36 bears S 16 lbs.

50 Set stake.

12-20-15