


Sec. 16 T. 1 N R. 33 E

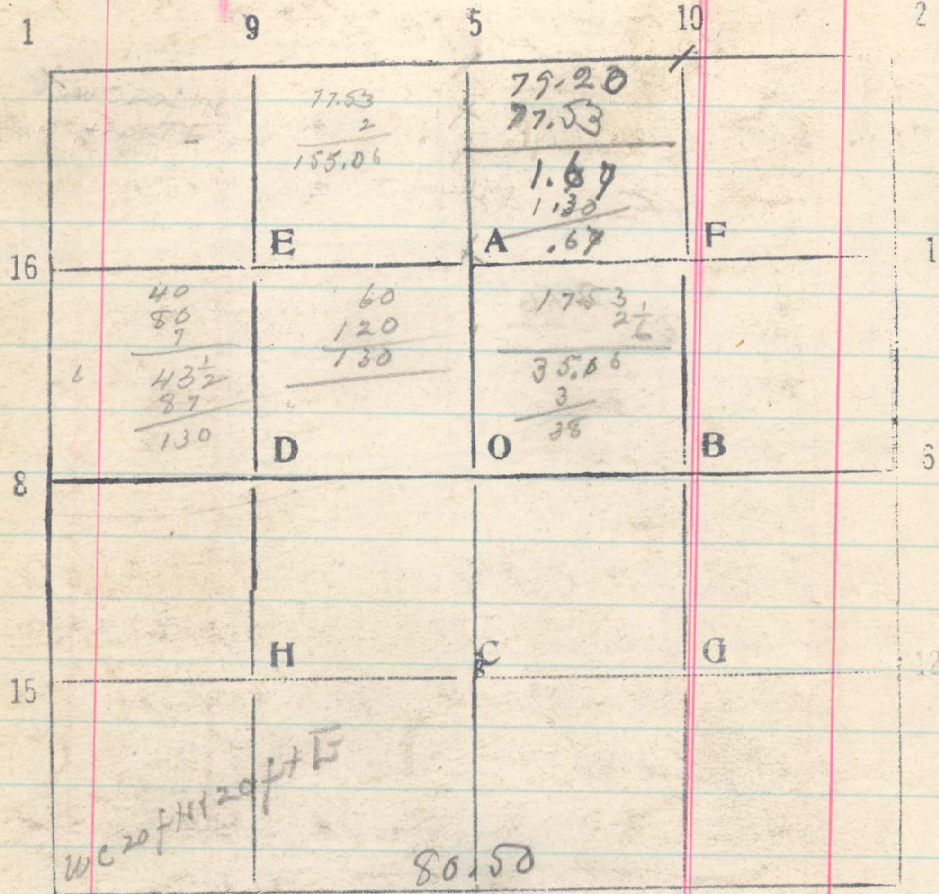

West bet 14 7 14

19.78 Set stake

39.76 Set stake

40.25 On line with fence to S, 34 1/2 lks N. of fence cor.

80.50 <sup>pt. for</sup> Interest cor of secs 8, 9, 16 + 17 April 16, 1917  
in center of crossroads

Sec. 8

West bet 8 + 17

20.11.15 Set stake  
Fence post at E end of main gate to N.  
40.00 Set 1/4 cor.

218

81.94 Interest pt. for cor of secs. 7, 8, 17 + 18  
in center of crossroads (4 W)

Sec. 7

Sec. 7 West bet. 7 + 18,

40.03 On line with fence to S. 49 lks N of fence  
on S. side of road + 40 lks S. of fence - N. end of road

60.00 Set stake WC 20 ft + 20 ft S

79.24 Interest C C of secs 7 + 8, stone with iron  
(77.53) post 1 lks E of it mld WC,

South bet. secs. 17 + 18.

40. Set stake (215-1 E)

40.15 On line with fence to W, 10 ft. E. of fence on W side  
O N line with fence to East 136 ft W of fence on side  
Pt. for cor of secs. 17, 18, 19 + 20, in center  
of crossroads, now fenced to E + W, bears E. 2 lks