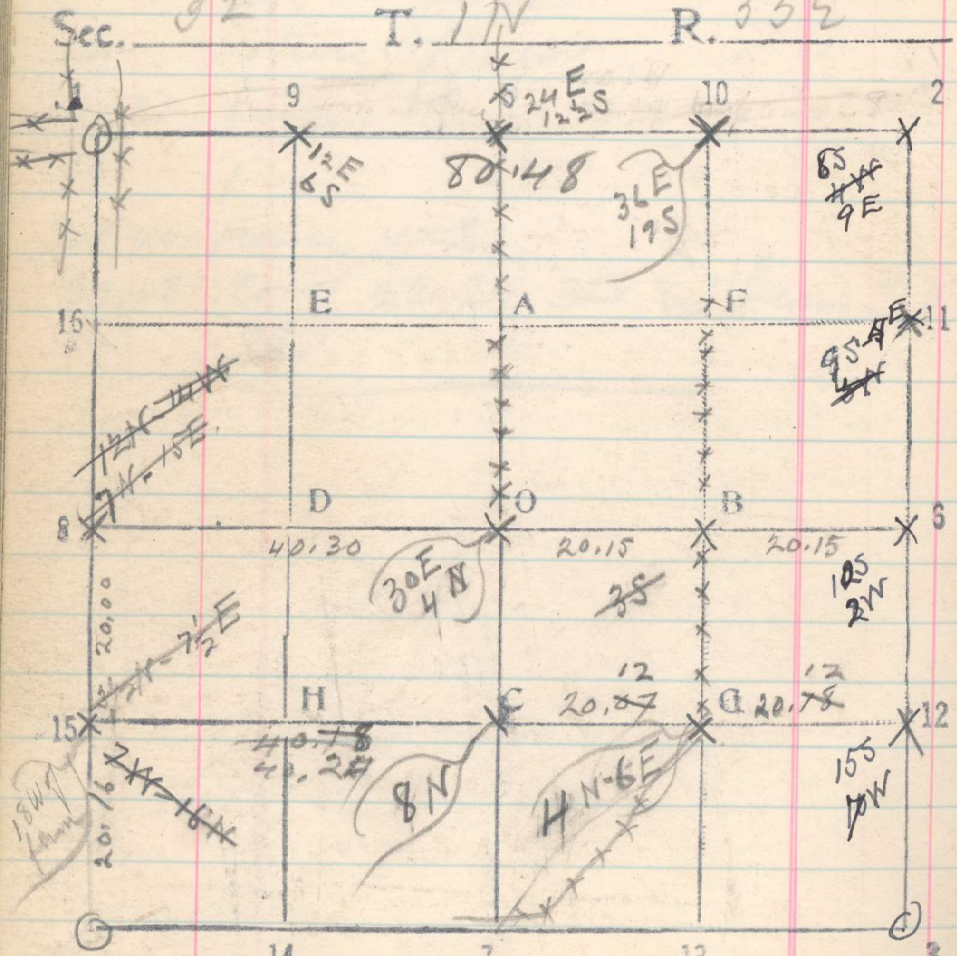

Dec 7 From temp 1/4 cor on S bdy Sec 32 run East by B.S. on Tp cor of R32 + 33 E. T1N

16.00 Set 1/16 cor for Sec 5

20 Set 1/16 cor for Sec 32

36 Set 1/16 cor.

39.76 SC. secs. 32 + 33, a stone well set + properly marked with notches, bears S. 106 lks.

From temp cor of 29.30.31 + 32 run East

40.45 ~~40.75~~ N + S fence

80.64 ~~80.99~~ temp cor of 28.29.32 + 33 bears S. 82 lks.

From cor of 31 + 32 on Base Line run North in road

20 Set stake for 1/16 cor, No trace of 1/16 cor.

20.21 On line with fence to west

39.50 Gulch. N80°W

40 No trace. Set stake in m.S.

40.32 On line with fence to east

80.14 Cor of 29.30.31 + 32 bears East 30 lks.

A stone 12 X 6 X 6 marked (+) + 5 notches on + 1 notch on S. set upside down. I set it right side up + build M.S. W of cor. 4 lks. West of N + S. fence on E side of road. + 2 lks. S. of line with fence on S. side of road to west