March 18, 1919. Found stone cut in ground, unmarked, in use & W. fence 2½ lks. N. & 48 lks. W. of stone post set by Wilkes.

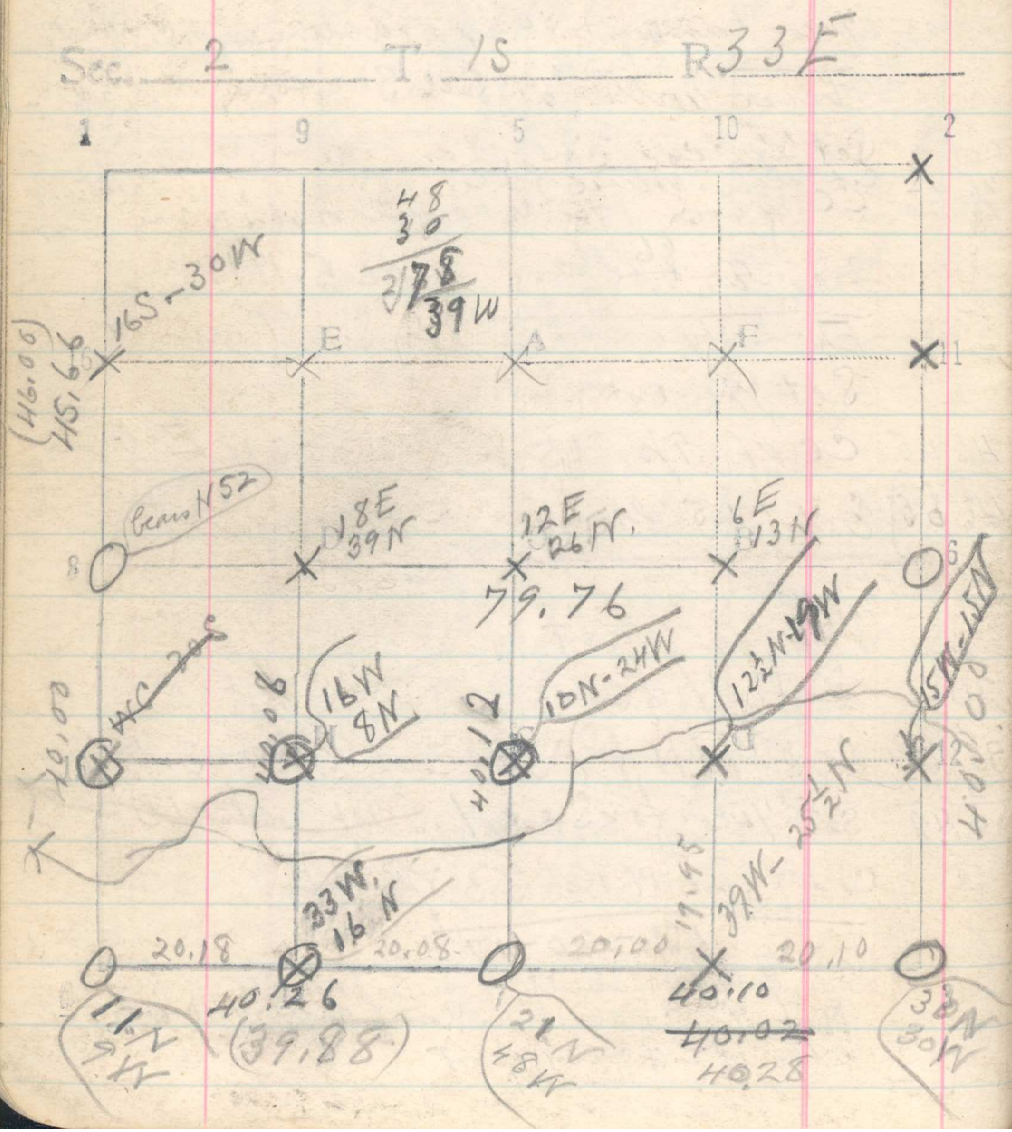

Dec 18 From cor of 2, 3, 10 & 11 run N
20.07 Set stake at top of cliff.
40.00 Intersect 1/4 cor, old stone marked 1/4, lying on ground, with stone 18 x 10 x 8 set 1 lk E of it Blazed WC 1/4 on W face. Pits N & W of cor. Rock 60 x 36 x 18 ins above gr. mkd X 1/4 2 B O bears N 35 E 10 lks.

Thence North
20. Set 1/16 cor: (16S - 30W)
45.66 C.C. of secs. 2 & 3 bears W. 69 lks.
(46.00)

From S-S. 2 runs S
20 Set 1/16 cor at H.
40.06 Intersect 1/16 cor.

From O-S. 2 runs S
20 Set 1/16 cor
40.12 Intersect 1/4 cor 1/10/18

3/28/19 Line 3-4.
20.10 Intersect 1/16 cor,
40.10 Intersect 1/4 cor bet 2 & 11.
19.96 Fence, N & S.
20.08 Intersect 1/16 cor — 40.26. Intersect cor of 2. 3. 10 & 11