


25 T. 2 R. 33

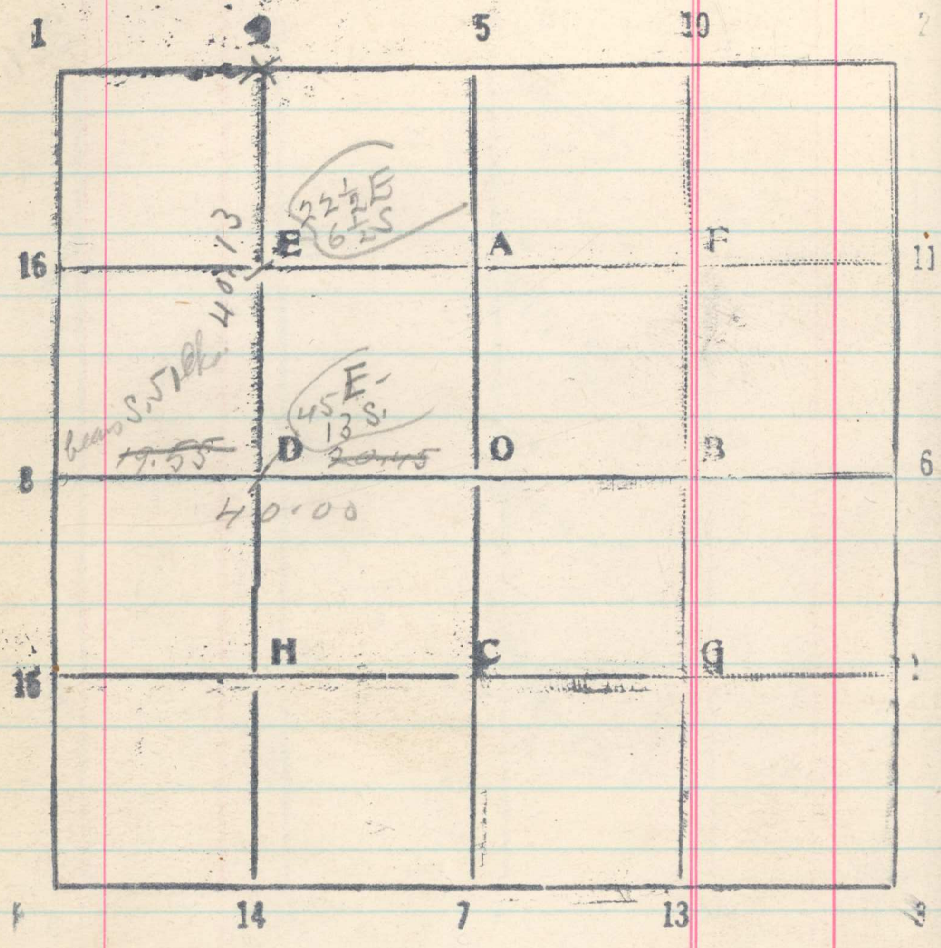

227