


R 23

2 N

34 E

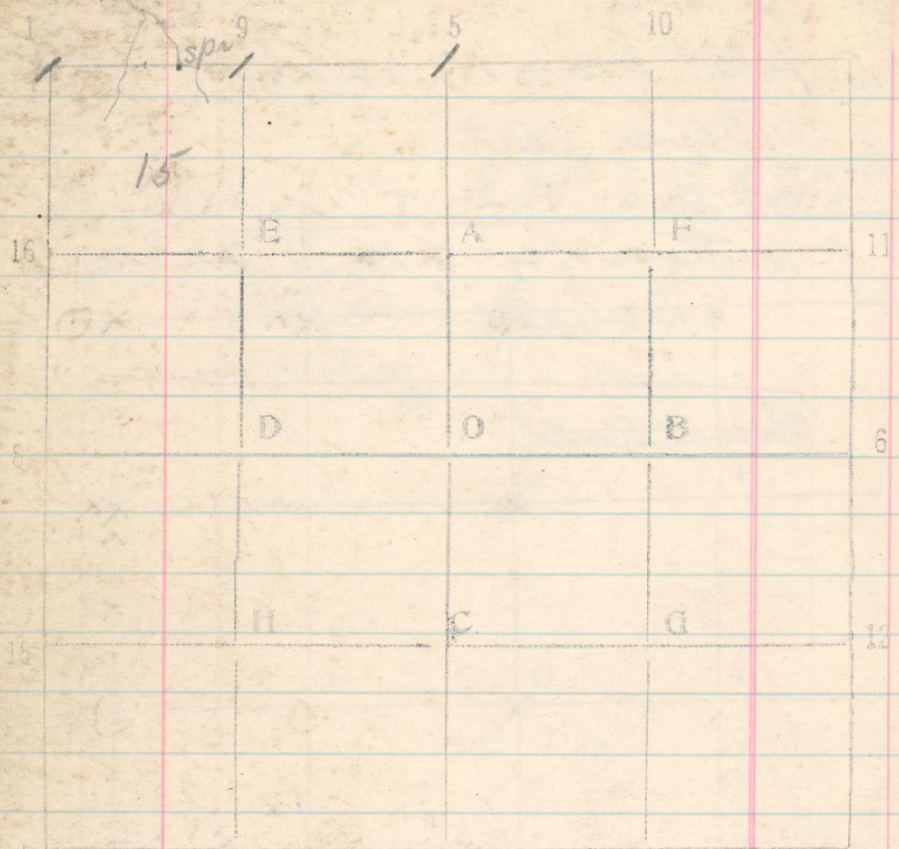

East from temp covy 14, 15, 22, 23