


Sec. 25 T. 2N R. 34E

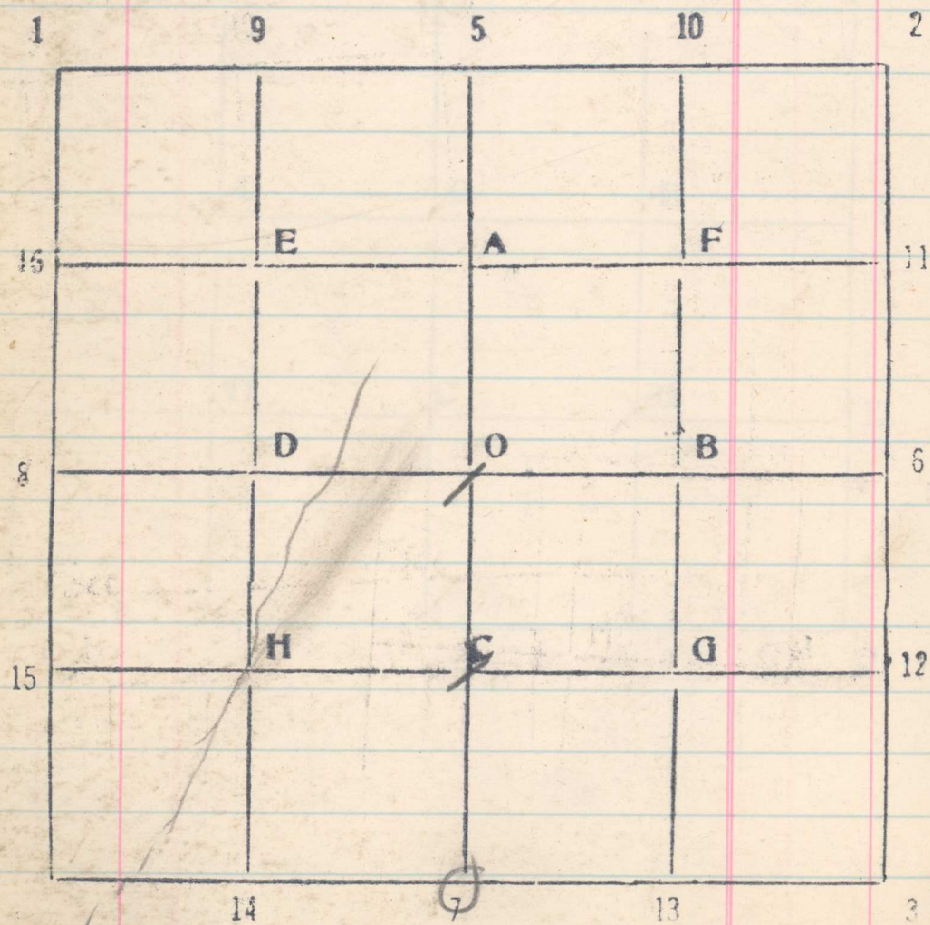

20  
40

from 7-5-25 run N  
Set  $\frac{1}{16}$   
Set  $\frac{1}{4}$  cor.