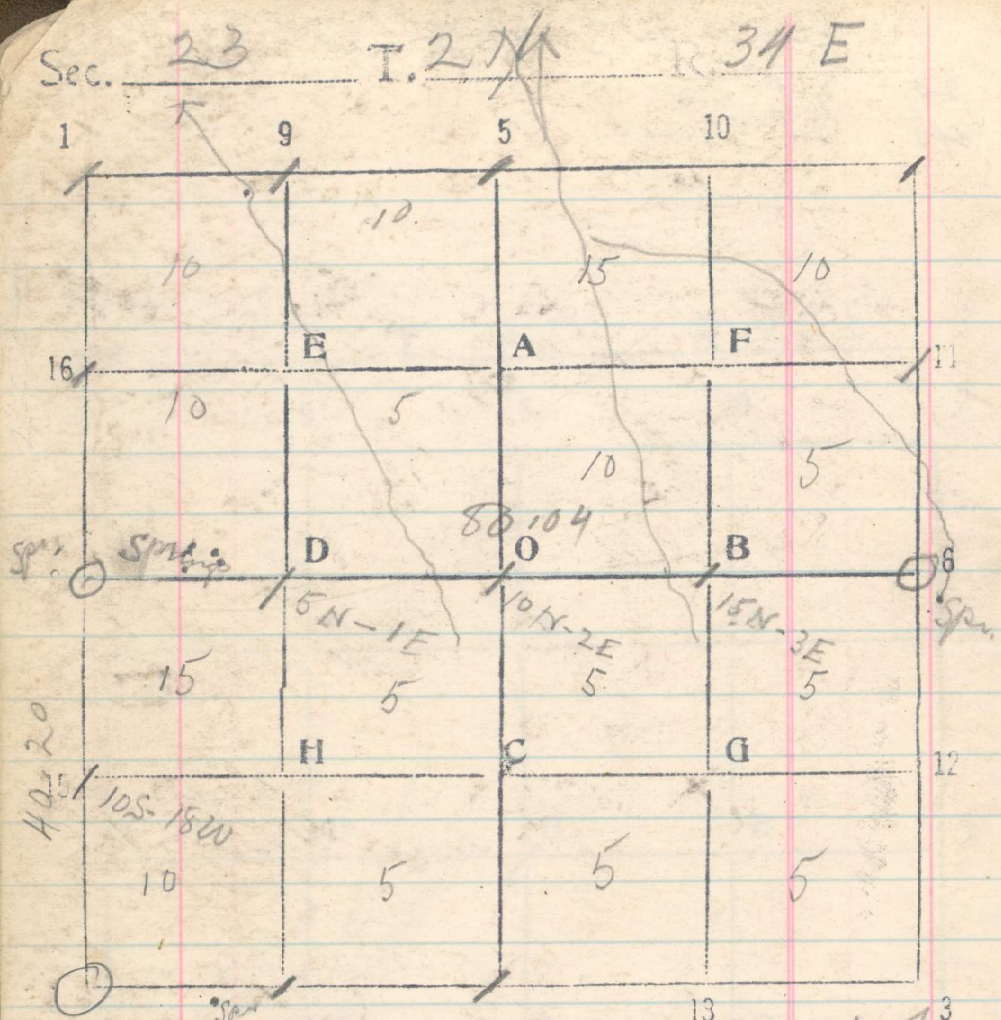

From temp. Cor of 14, 15, 22 & 23 run from west. run South

20 Set 1/16 Cor

40.91 1/4 cor bet 22 & 23, a stone in MS bears W. 4/4 lks.

Thence East through

Center of Sec 23

20. Set 1/16 Cor

40. Set 1/4 Cor

60 Set 1/16 Cor

80.04 1/4 Cor bet 23 & 24 bears N. 25 lks

Thence North

20 Set 1/16 Cor.

40. No trace of Cor of 13, 14, 23 & 24

Set stake June 20.

From ~~Cor~~ of 22, 23, 26 & 27 run East.

20 Set 1/16 Cor.

40 ~~Set 1/4~~ No trace of 1/4 Cor. Set stake June 24, 1915