

7.34

20

754

7.34

732.5

303

415.15

278 ft on N side RR

200 ft. " S "

RR

200

303

2498 ft

249


747

7.5

754.5

RR corners established about 12 years ago.

Sec. 4 T. 2N R. 34E

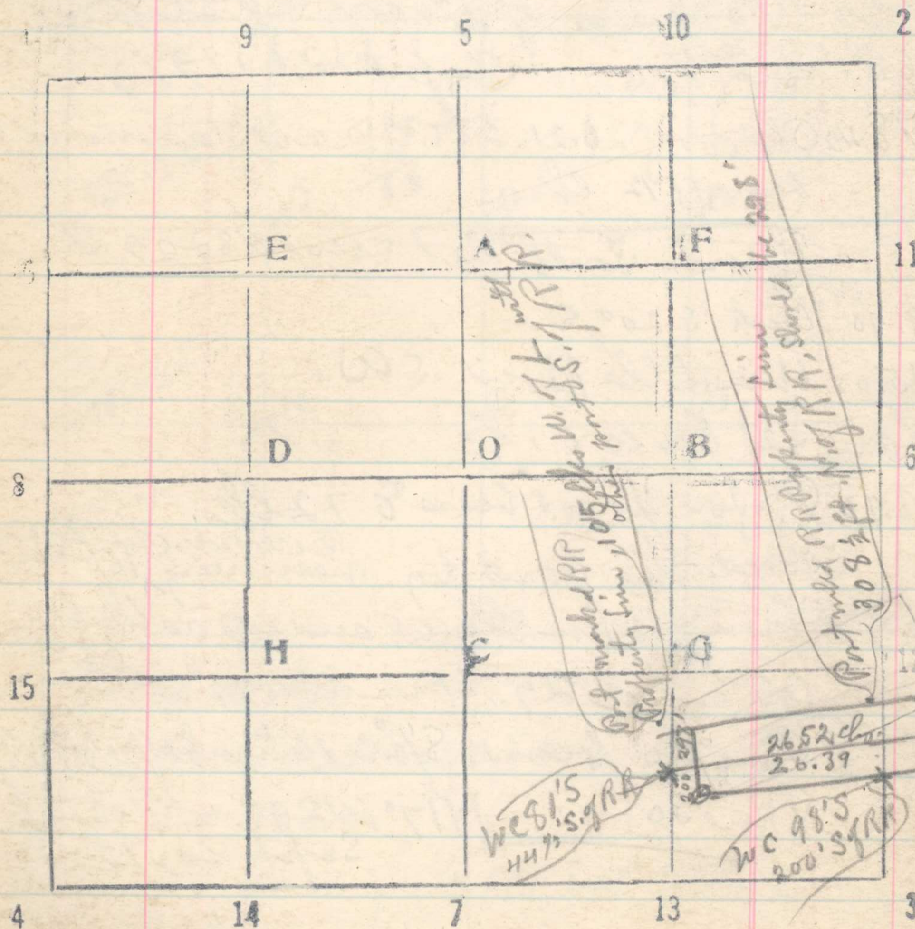

7.54

2000.00

26.52

1508

1380

16

298

179

26.53

20.60

4920

5280

44.7

7.54

10200

3960

1380

45

106024126

3820

42050

4515

13265

51800

145

690

18571

42778

2000362

181