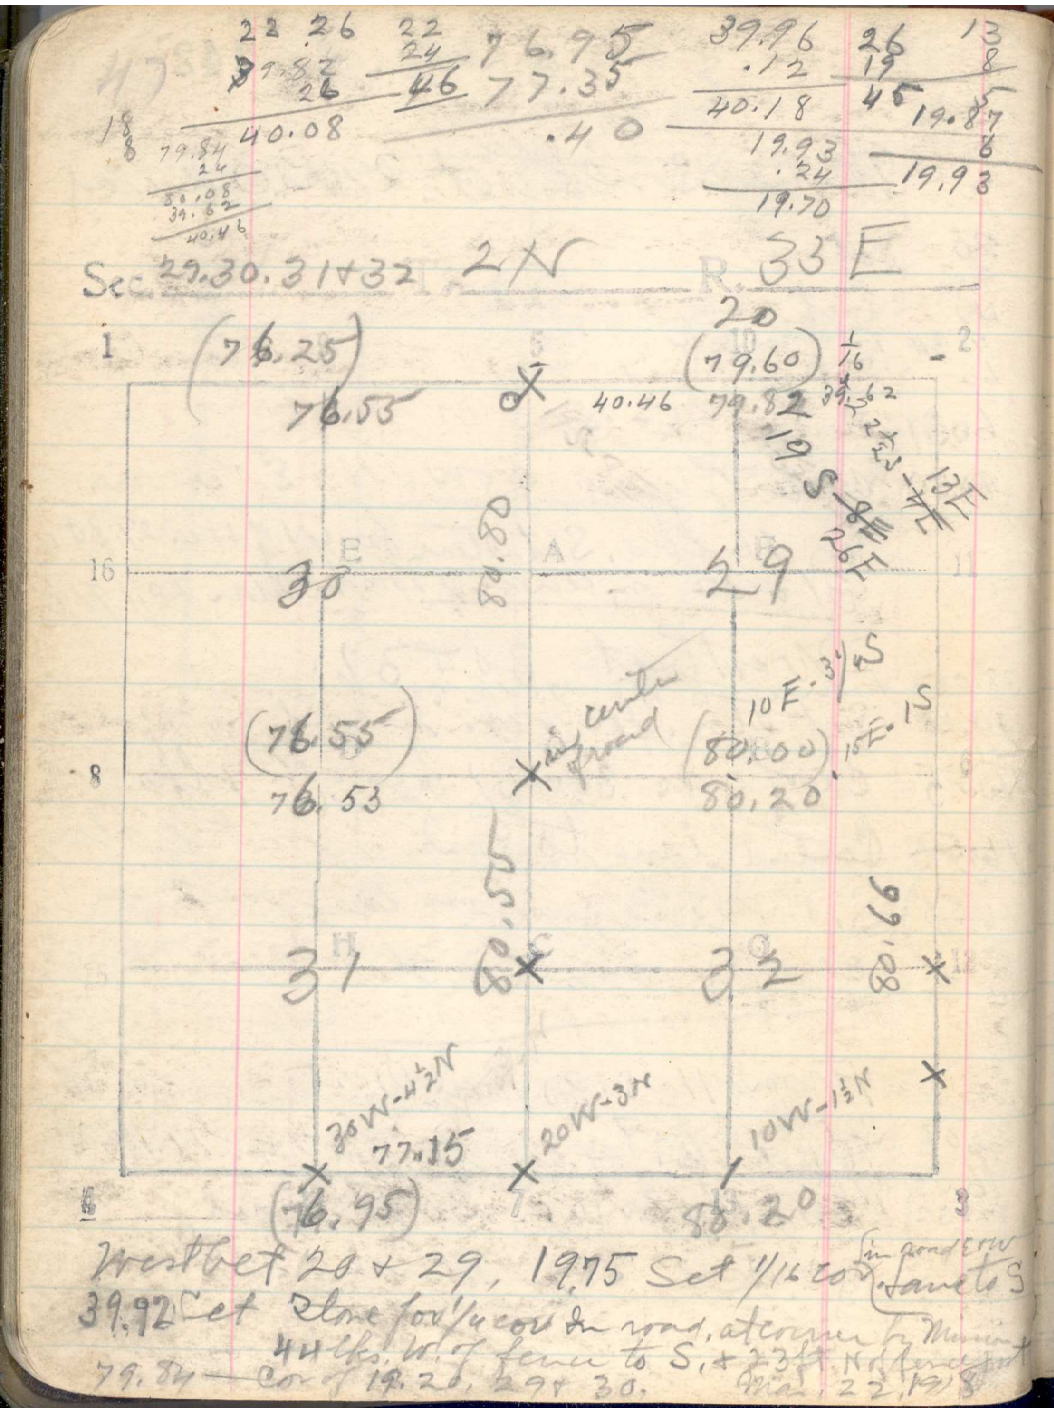
Sec. 29.30.31+32 2N R 33E
West bet 28+29, 1975 Set 1/16 cor
39.92 Set Stone for 1/4 cor in road, at corner to Mining
44 lks. W. of fence to S. + 23 ft. N. of fence
79.84 Cor of 19.20.29+30.
Fence to S.
