Sec. 14 T. 2 N. 35 E.

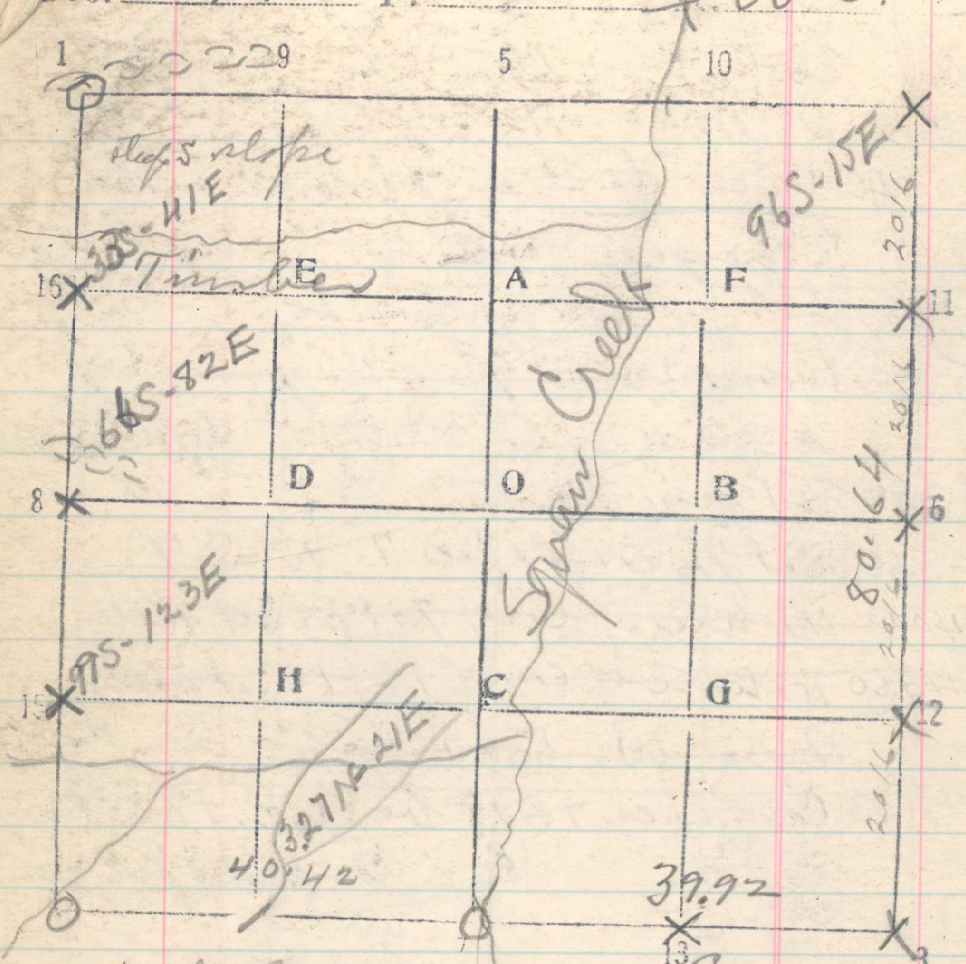

South bet 14 & 15.

20 Set 1/16

40 No trace of 1/4 cor.

60 Set 1/16

80 Cor of 14, 15, 22 & 23 bears S 51¼° E 21 lks. (132 S-164 E)

81.32 Pt for cor of 14, 15, 22 & 23 bears E. 164 lks.

Dislocated this corner by measuring N 56° W 9 lks. from BT. in 3 faces of pine 12, marked S 23 T 2 N BT. Recorded as pine 8 S 80° E 39 lks. From this point a pine 14 bears S 39 W 40 lks, marked S 22, T 2 N R 35 E Recorded as pine 10 S 50° W 60 lks On account of error in recording bearing & dist to BTs, I locate corner as above, which the blaze on both Bearing trees face.

Thence East bet 14 & 23

20.00 Set 1/16 cor. - 3.00 lks S. of line.

40.42 1/4 cor bet 14 & 23. a decayed pine stump 30 ins. no marks visible, bears N, 5 lks pine 36 N 57° E 54 lks. mk 1/4 S BT Pine 30 S 73° E 51 lks mk 1/4 S BT

Thence East

20 Set 1/16 cor

39.92 Cor of 13, 14, 23 & 24 bears N, 1 90 lks.

Sept 16, 1918

12 - S. 14 on W

15 - S - 13 on E.

1/16 on N & S.