


Sec. 5 T. 2 N R. 35 E.

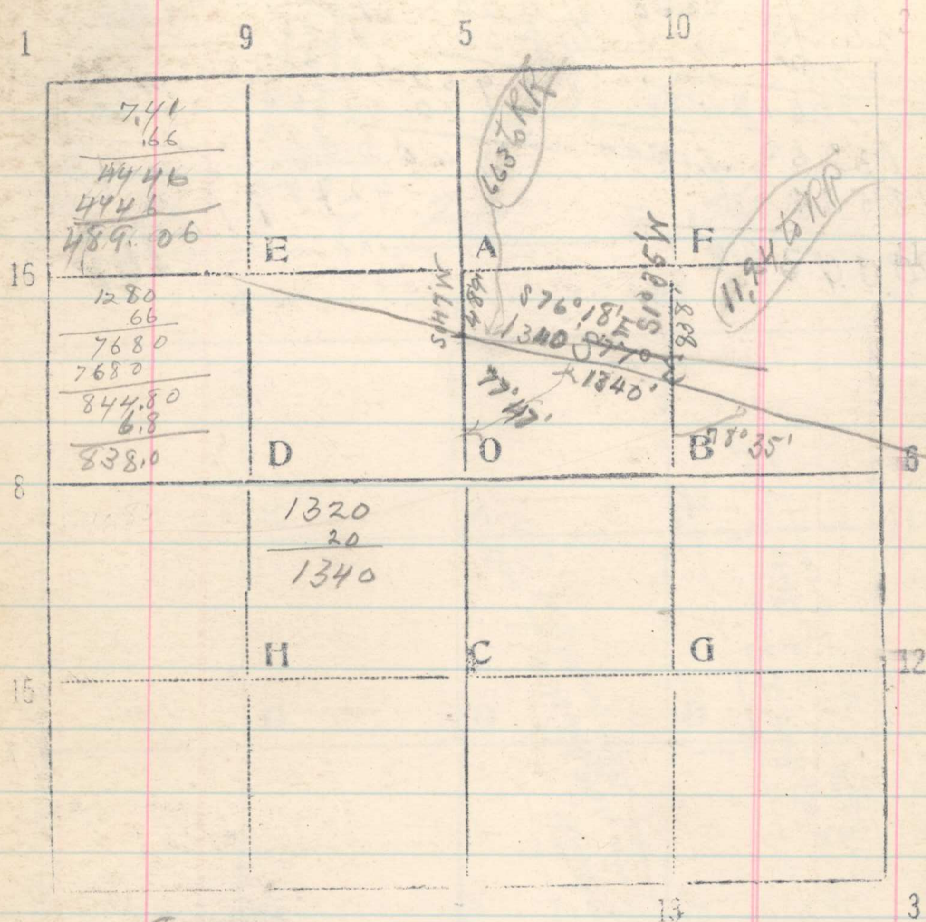

To locate pipe line from  
 A-S-5, South  $0^{\circ} 47' W$  by class  
 cartelli, insert fence is about 20 feet W. of line  
 DWRON by  $S 77^{\circ} E$   
 S. side of  $0^{\circ} 47' R + N. R/W$ , (489 feet)  
 Center of pipe line  $S 77^{\circ} E$

6.53  
 (489) 7.41  
 7.41  
 7.41

838'  
 $\frac{11.945}{.782}$   
 $\frac{6.63}{.78}$   
 $\frac{12.72}{7.41}$

From F-S 15 run  $S 1^{\circ} 40' W$  by class

11.94 Center of RR  $N 77^{\circ} W$   
 12.72 S. of well fence  
 12.80 Pipe line  $N 77^{\circ} W$ , 5 feet E. of center  
 of Man Hole, and 66 feet E. of Sta  
 1314'

12.70  
 66  
 762.8  
 762.0  
 539.20  
 7.41  
 66  
 44.46  
 44.46  
 489.06

183