


Sec. 18 T. 2N R. 26E

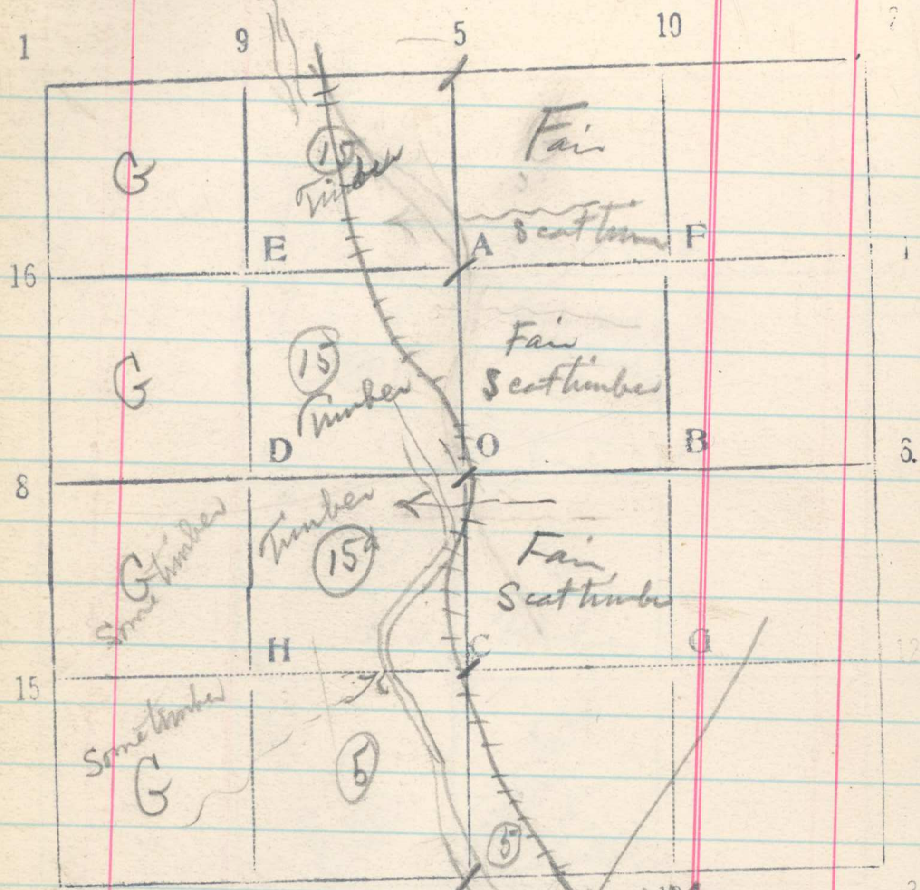

From temp cor of 7+18 set from N  
run South

- 20 Set 1/16 A-S. 18
- 40 Set 1/16 cor B-S. 18 just W of RR
- 60 Set 1/16 cor C-S. 18, just E of RR
- 86.00 Falls in Creek chagne, Set stake,  
Set stake 2.00 chgs on E bank of creek