


Sec. 33 T. 3 N. R. 35 E.

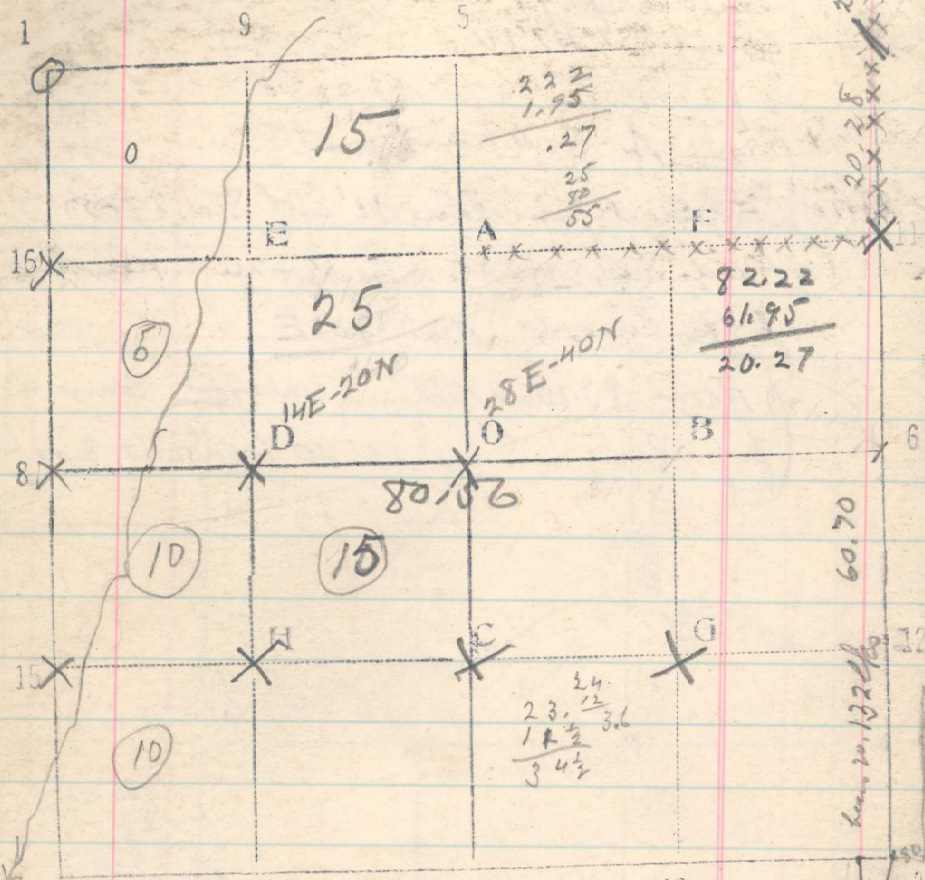

From 8-S-33 run East

- 20. Notation Set $\frac{1}{16}$ cor.
- 40. Notation Set $\frac{1}{4}$ cor.
- 60. Notation. Set $\frac{1}{16}$ cor in stubble
- 80. Notation. Set Stake.
- 80.56 $\frac{1}{4}$ cor bet 33 & 34 bears S. 80 lks.

Thence North.

20.99
40.

Fence post, 12 lks W. of fence cor N. 184
Set stake for temp cor of 27, 28, 33 & 34

Thence North on same line

21.55

Fence post, 25 lks W of fence cor. N. S. & W
Place turn 10 to right

61.95

Fence cor, S & E, bears E. 25 lks.

82.22

Center of road E & W, on line with fence
to N., bears East 80 lks, probably pt. fence 21, 22, 27
28