Sec. 1 28 T. 2 N R. 5 E.

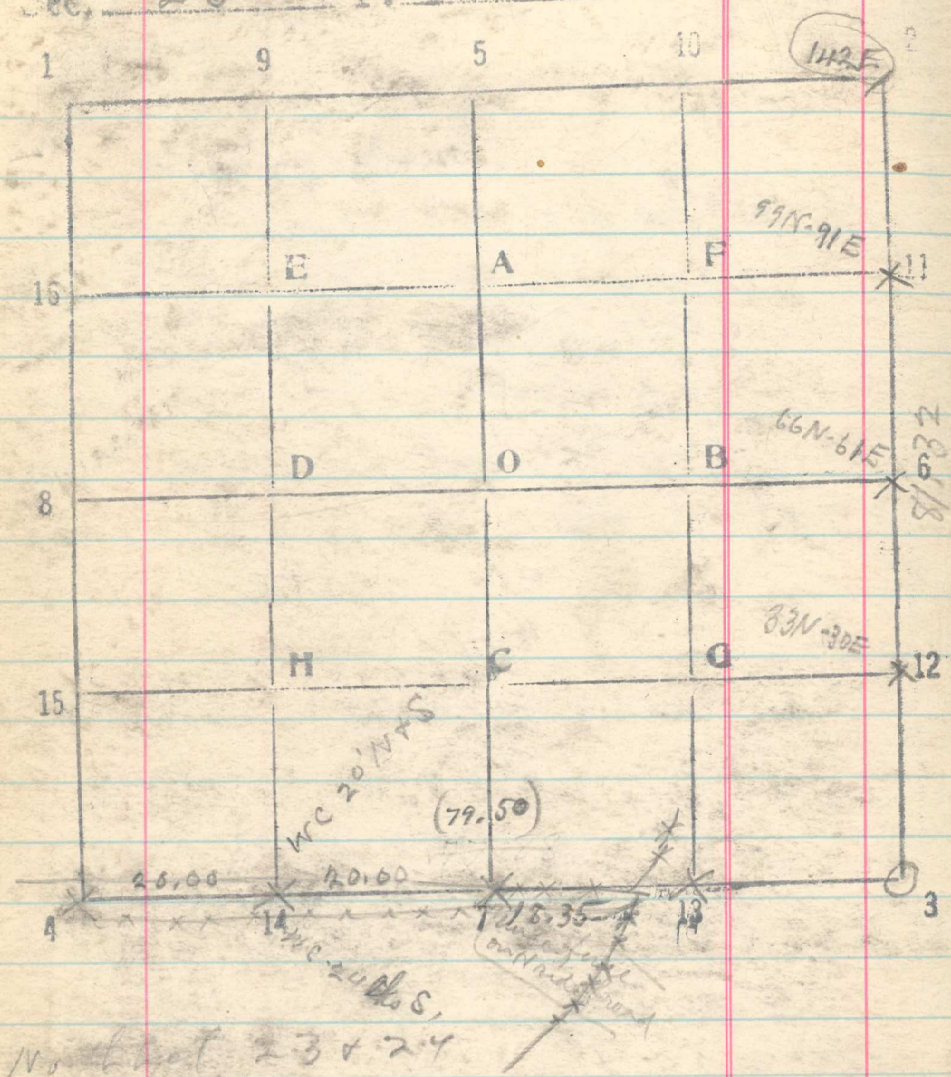

N. 1 Set 23 & 24
20.00 S. of 1/16 corner of Sec. Set
N.
60 Set
81.22 27 for cor. of 13.14.23.24 bears 2.22 W.
N.

21
80.00
20.62 20.20
40.48E
28
27
+.98
76.90
77.88
19.48½
19.48½
48E
54E
60N.
105W.
27
23
+193
79.50
80.14
152
160½
8½
8½
8½
8½
46
53
111
58
53
58
53
22
3/12
40.00
76.98
79.50
196.40
20.00
3.60
1.52
2.08
1.64
48
3.10
2.12
.98
4) 2.12
53
76.90
84
4) 77.74
19.43½
.56½
.42
1.48
19.22½
71
58½
1.27½
56½
184
1.73
.21
1.94
21
2.16
21
2.36
5
4) 1.22
30
12.34
86
N 7

Northeast 13 & 14 (from pt. 42 lks. E. of Cor.
20. Set 1/16 cor in stone
40 Set 1/4 cor in stone
60.15 Pt for 1/16 cor bears W. 6 lks, located from old 13.1.6

Thence north to S.E. cor. Sec. Cor.
16.82 Set W.C. to mound under fence
19.60 Cor of 1.12.11 & 12, a stone mound N. 11 W. bears E. 21 lks

June 3, 1919. East bet 23 & 26
20. Set W.C. 1/16 20 ft. N. & 20 ft. S.
40. Set 1/4 cor., under fence & N. side of road
80.00 1/16 cor 14 - S. 23
80.00 Cor of 23.24.25 & 26